
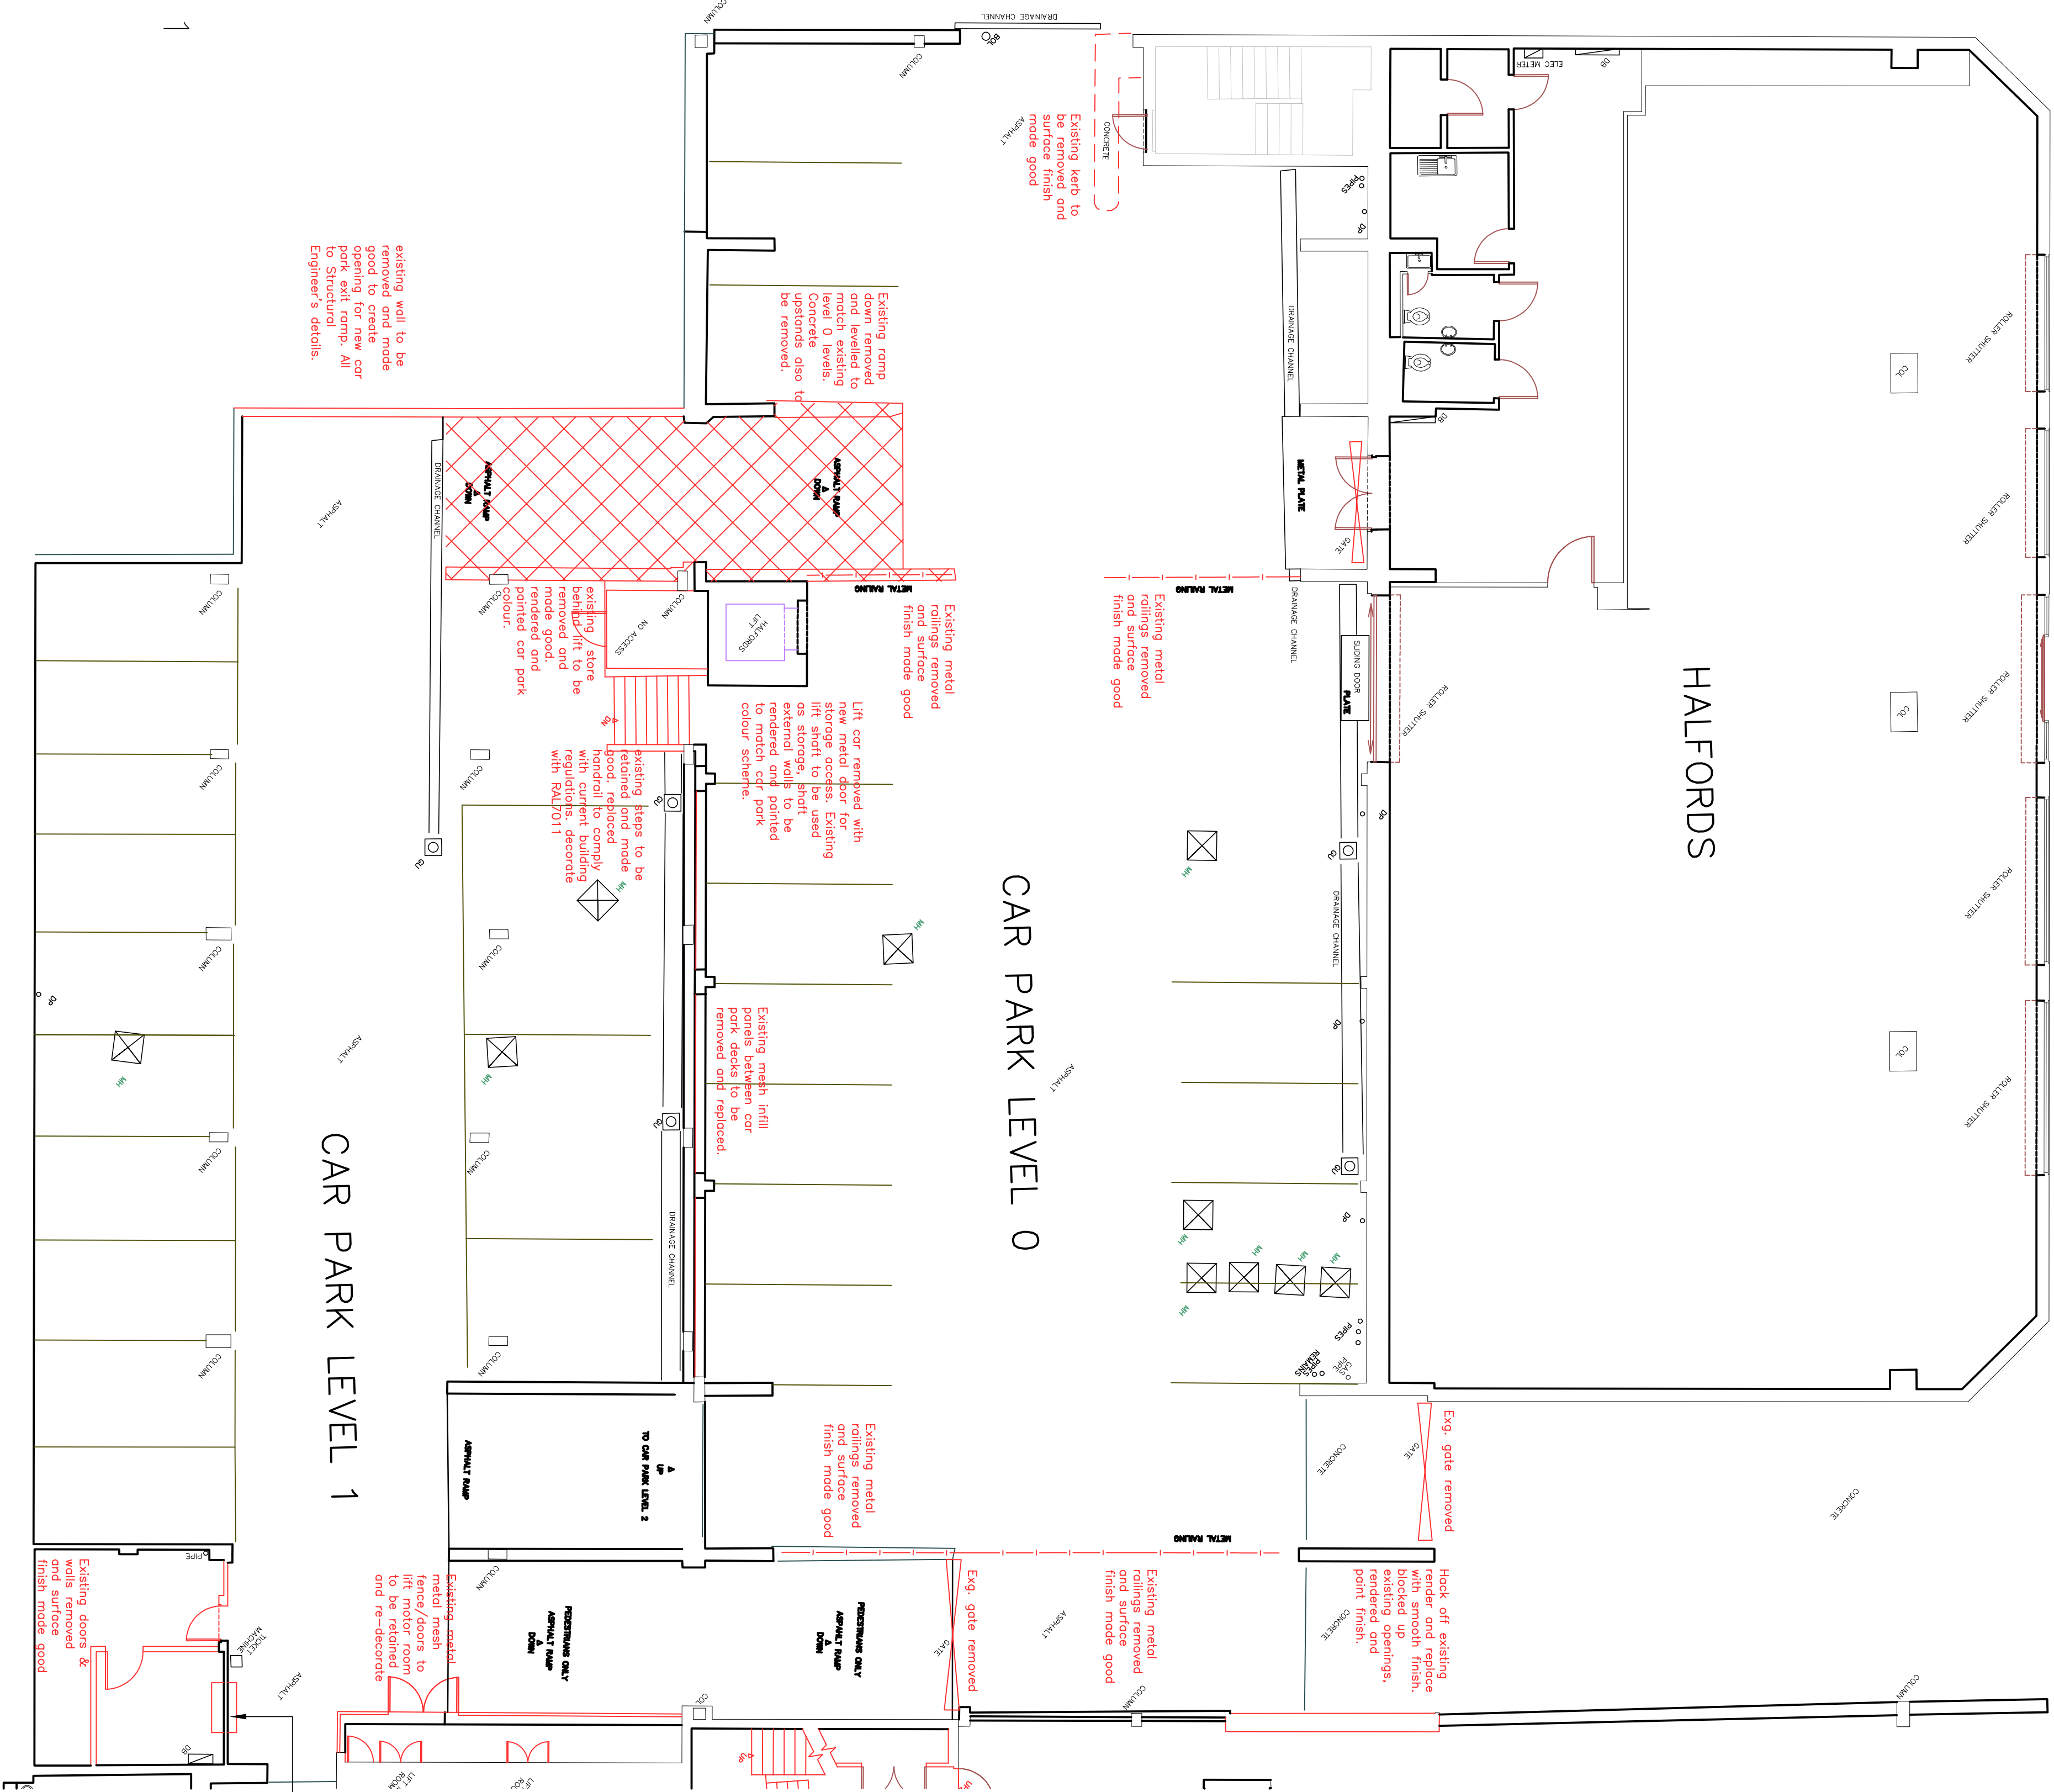


Existing Car park level 0 & 1
Demolition plan
Scale 1:100

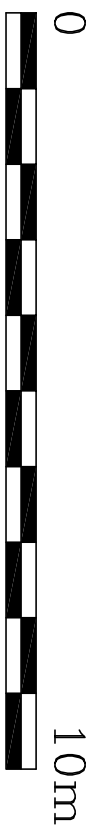

- Car Park Notes:
- Existing car park and surface to be removed and surface finish mode good to specialist contractor details.
 - Car park colour scheme:
 - Road ways, Columns to 600mm from FFL & Parking bays – Ral 7011 Grey
 - Walkways, column upper directional markings & parking bay lines – Ral 6036 Green
 - Car park soffit – Ral 9016 White
 - Further details & product references regarding new vehicle and ramp barriers can be found on drawings BS105-120 & BS105-121

— To be removed/demolished. See associated notes

as built drawing

 MERRYWALKS RETAIL CENTRE KING STREET, STROUD, GL5 1RR for STROUD REGENERATION LIMITED		
EXISTING CAR PARK CAR PARK – LEVEL 0 & 1 DEMOLITION PLAN		
Date: 23/05/18	Drawn: PN	Checked: 8510S/101B

Dixon Dawson Chartered Architects
6 Moor Oaks Road
Bromhill
S10 1BX
T 0114 2683888
F 0114 2683887
E info@dixon-dawson.co.uk

REVISION B : 01 MARCH 2019 :
DRAWING ISSUED FOR AS BUILT INFORMATION
REVISION A : 31 AUGUST 2018 :
NOTES UPDATED, CONSTRUCTION ISSUE
PN

Do not scale. All calling out dimensions to be site confirmed prior to works commencing and any discrepancies confirmed to architect. This drawing is to be read in conjunction with all other architectural and structural engineers drawings.