




MERRYWALKS

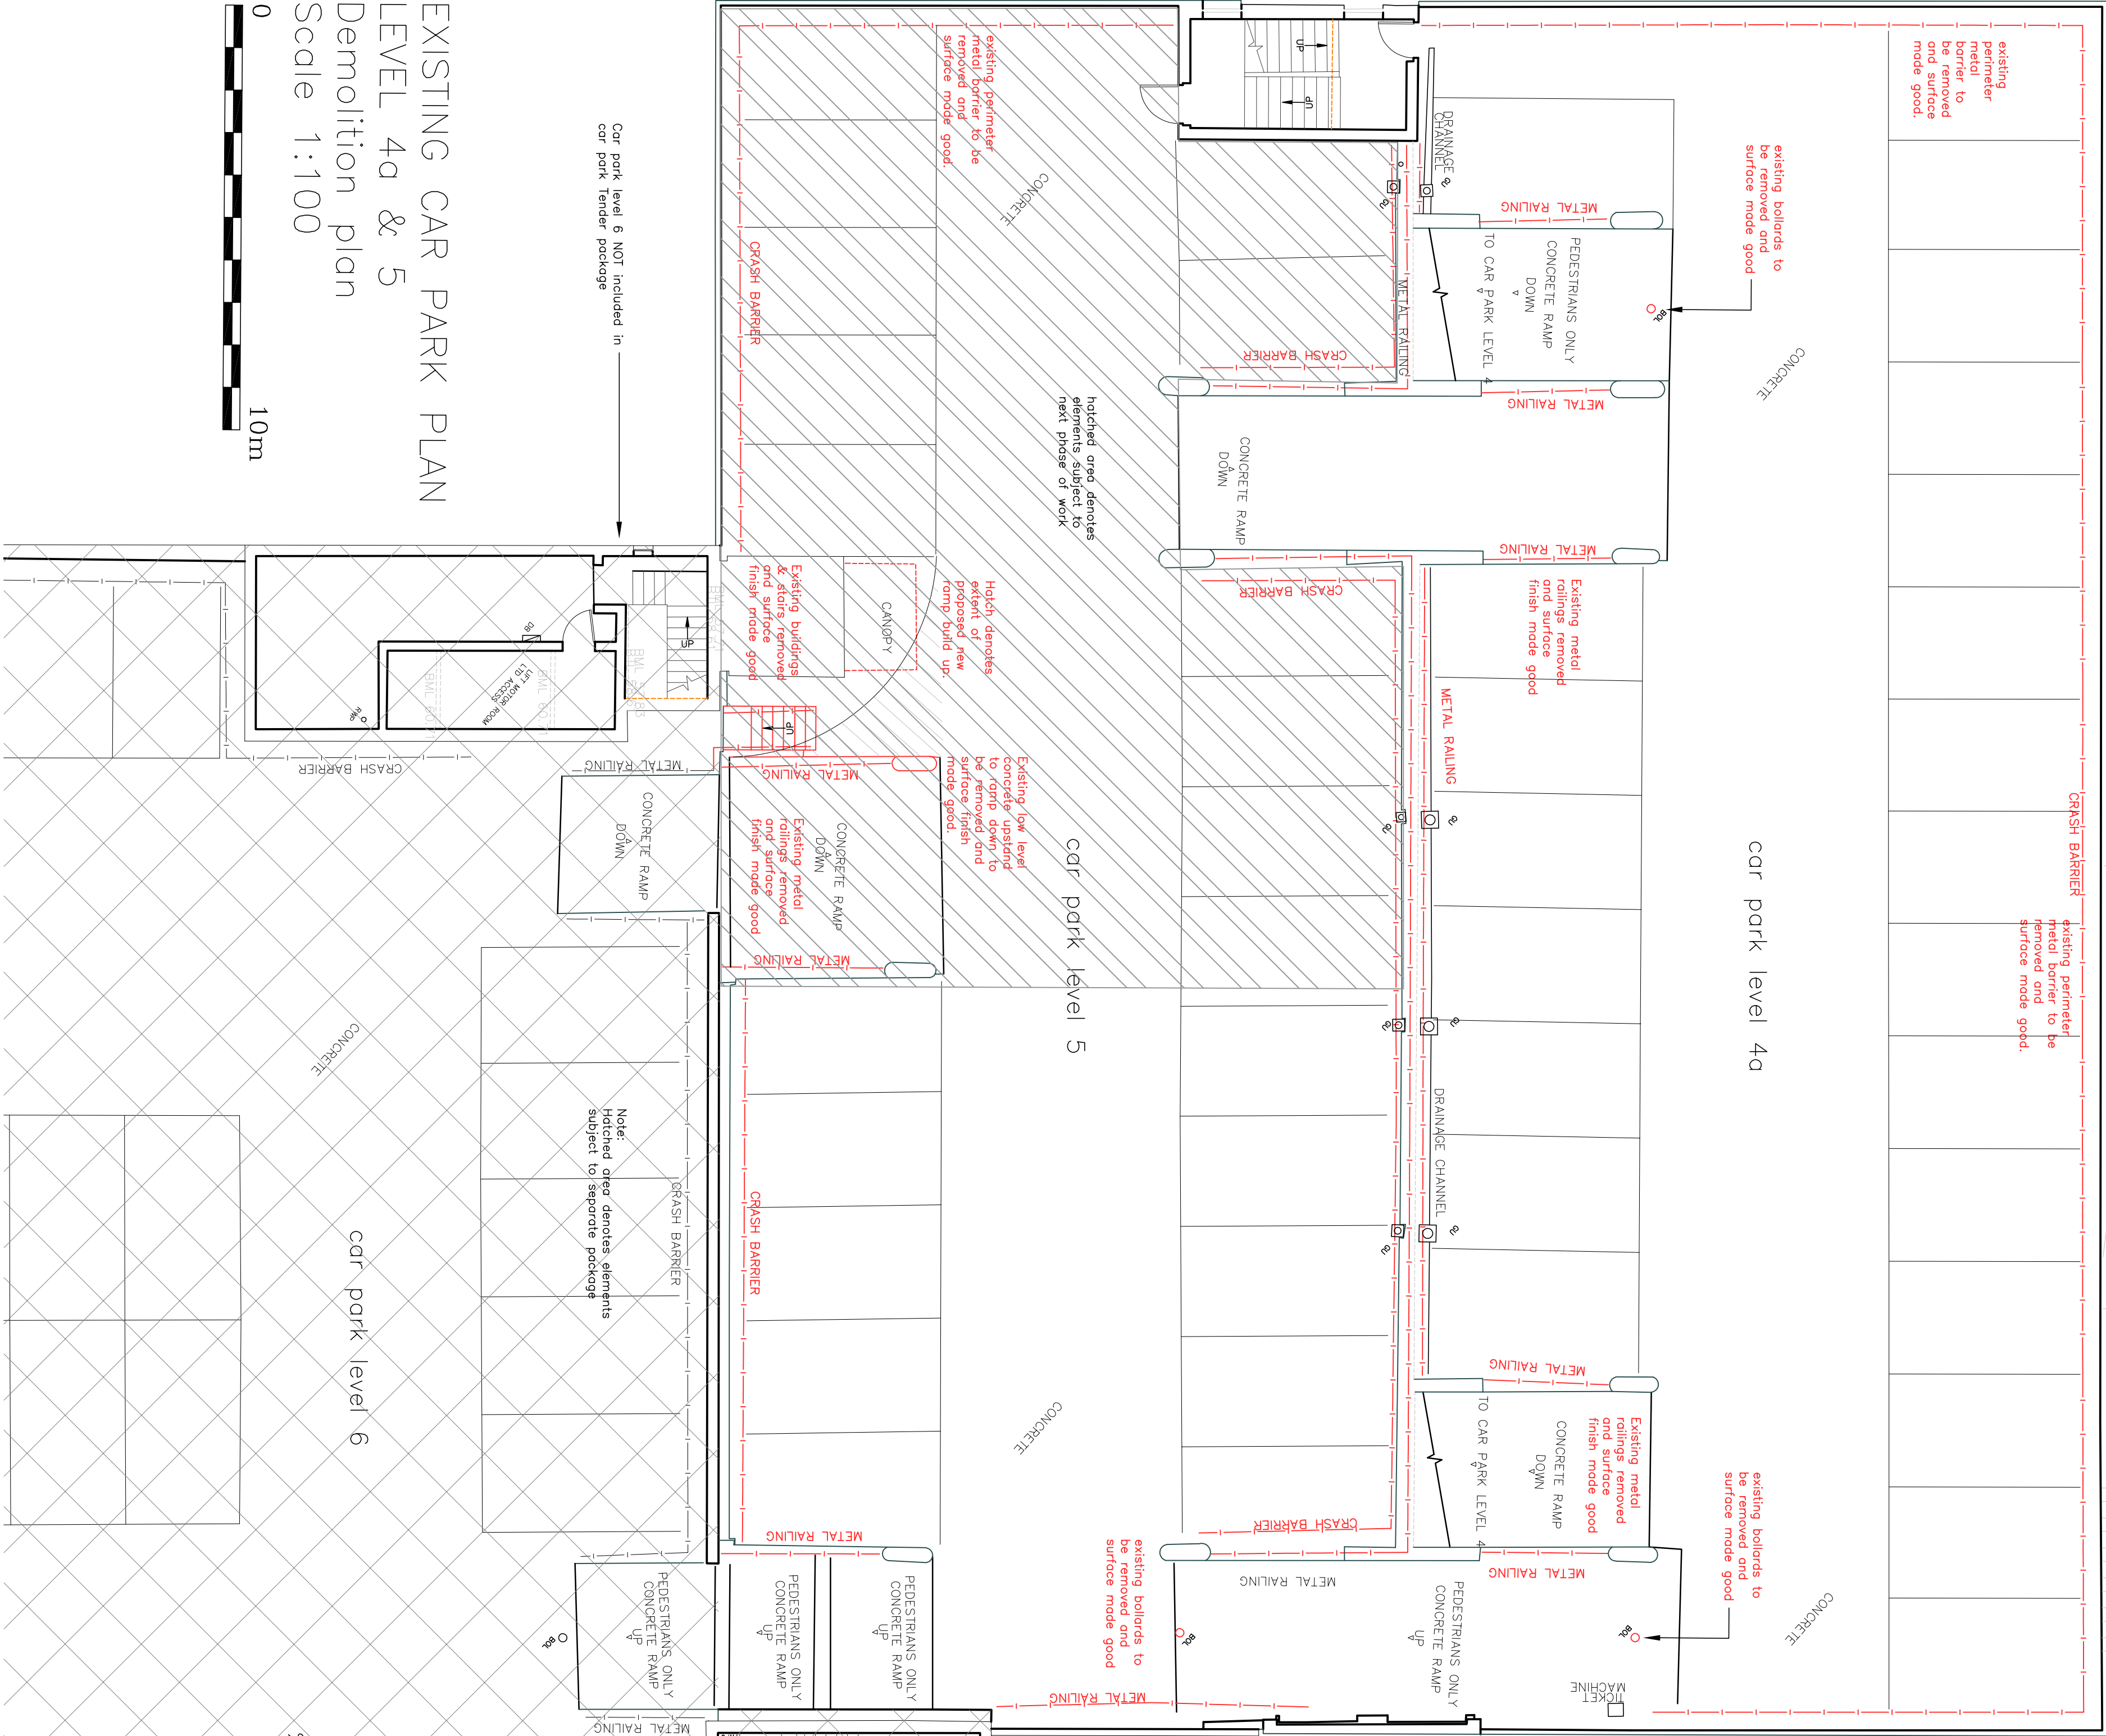

- Car Park Notes:
- Existing car park road surface to receive full resurface to specialist contractor details.
 - Car park colour scheme:
 - Road ways, Columns to 600mm from FTL & Parking bays – Red
 - Directional walkways, column upper, lines – Red
 - Car park soffit – Red
 - Further details & product references regarding new vehicle and ramp structures are provided in drawings 8510s-120 & 8510s-121.
- To be removed/demolished. See associated notes

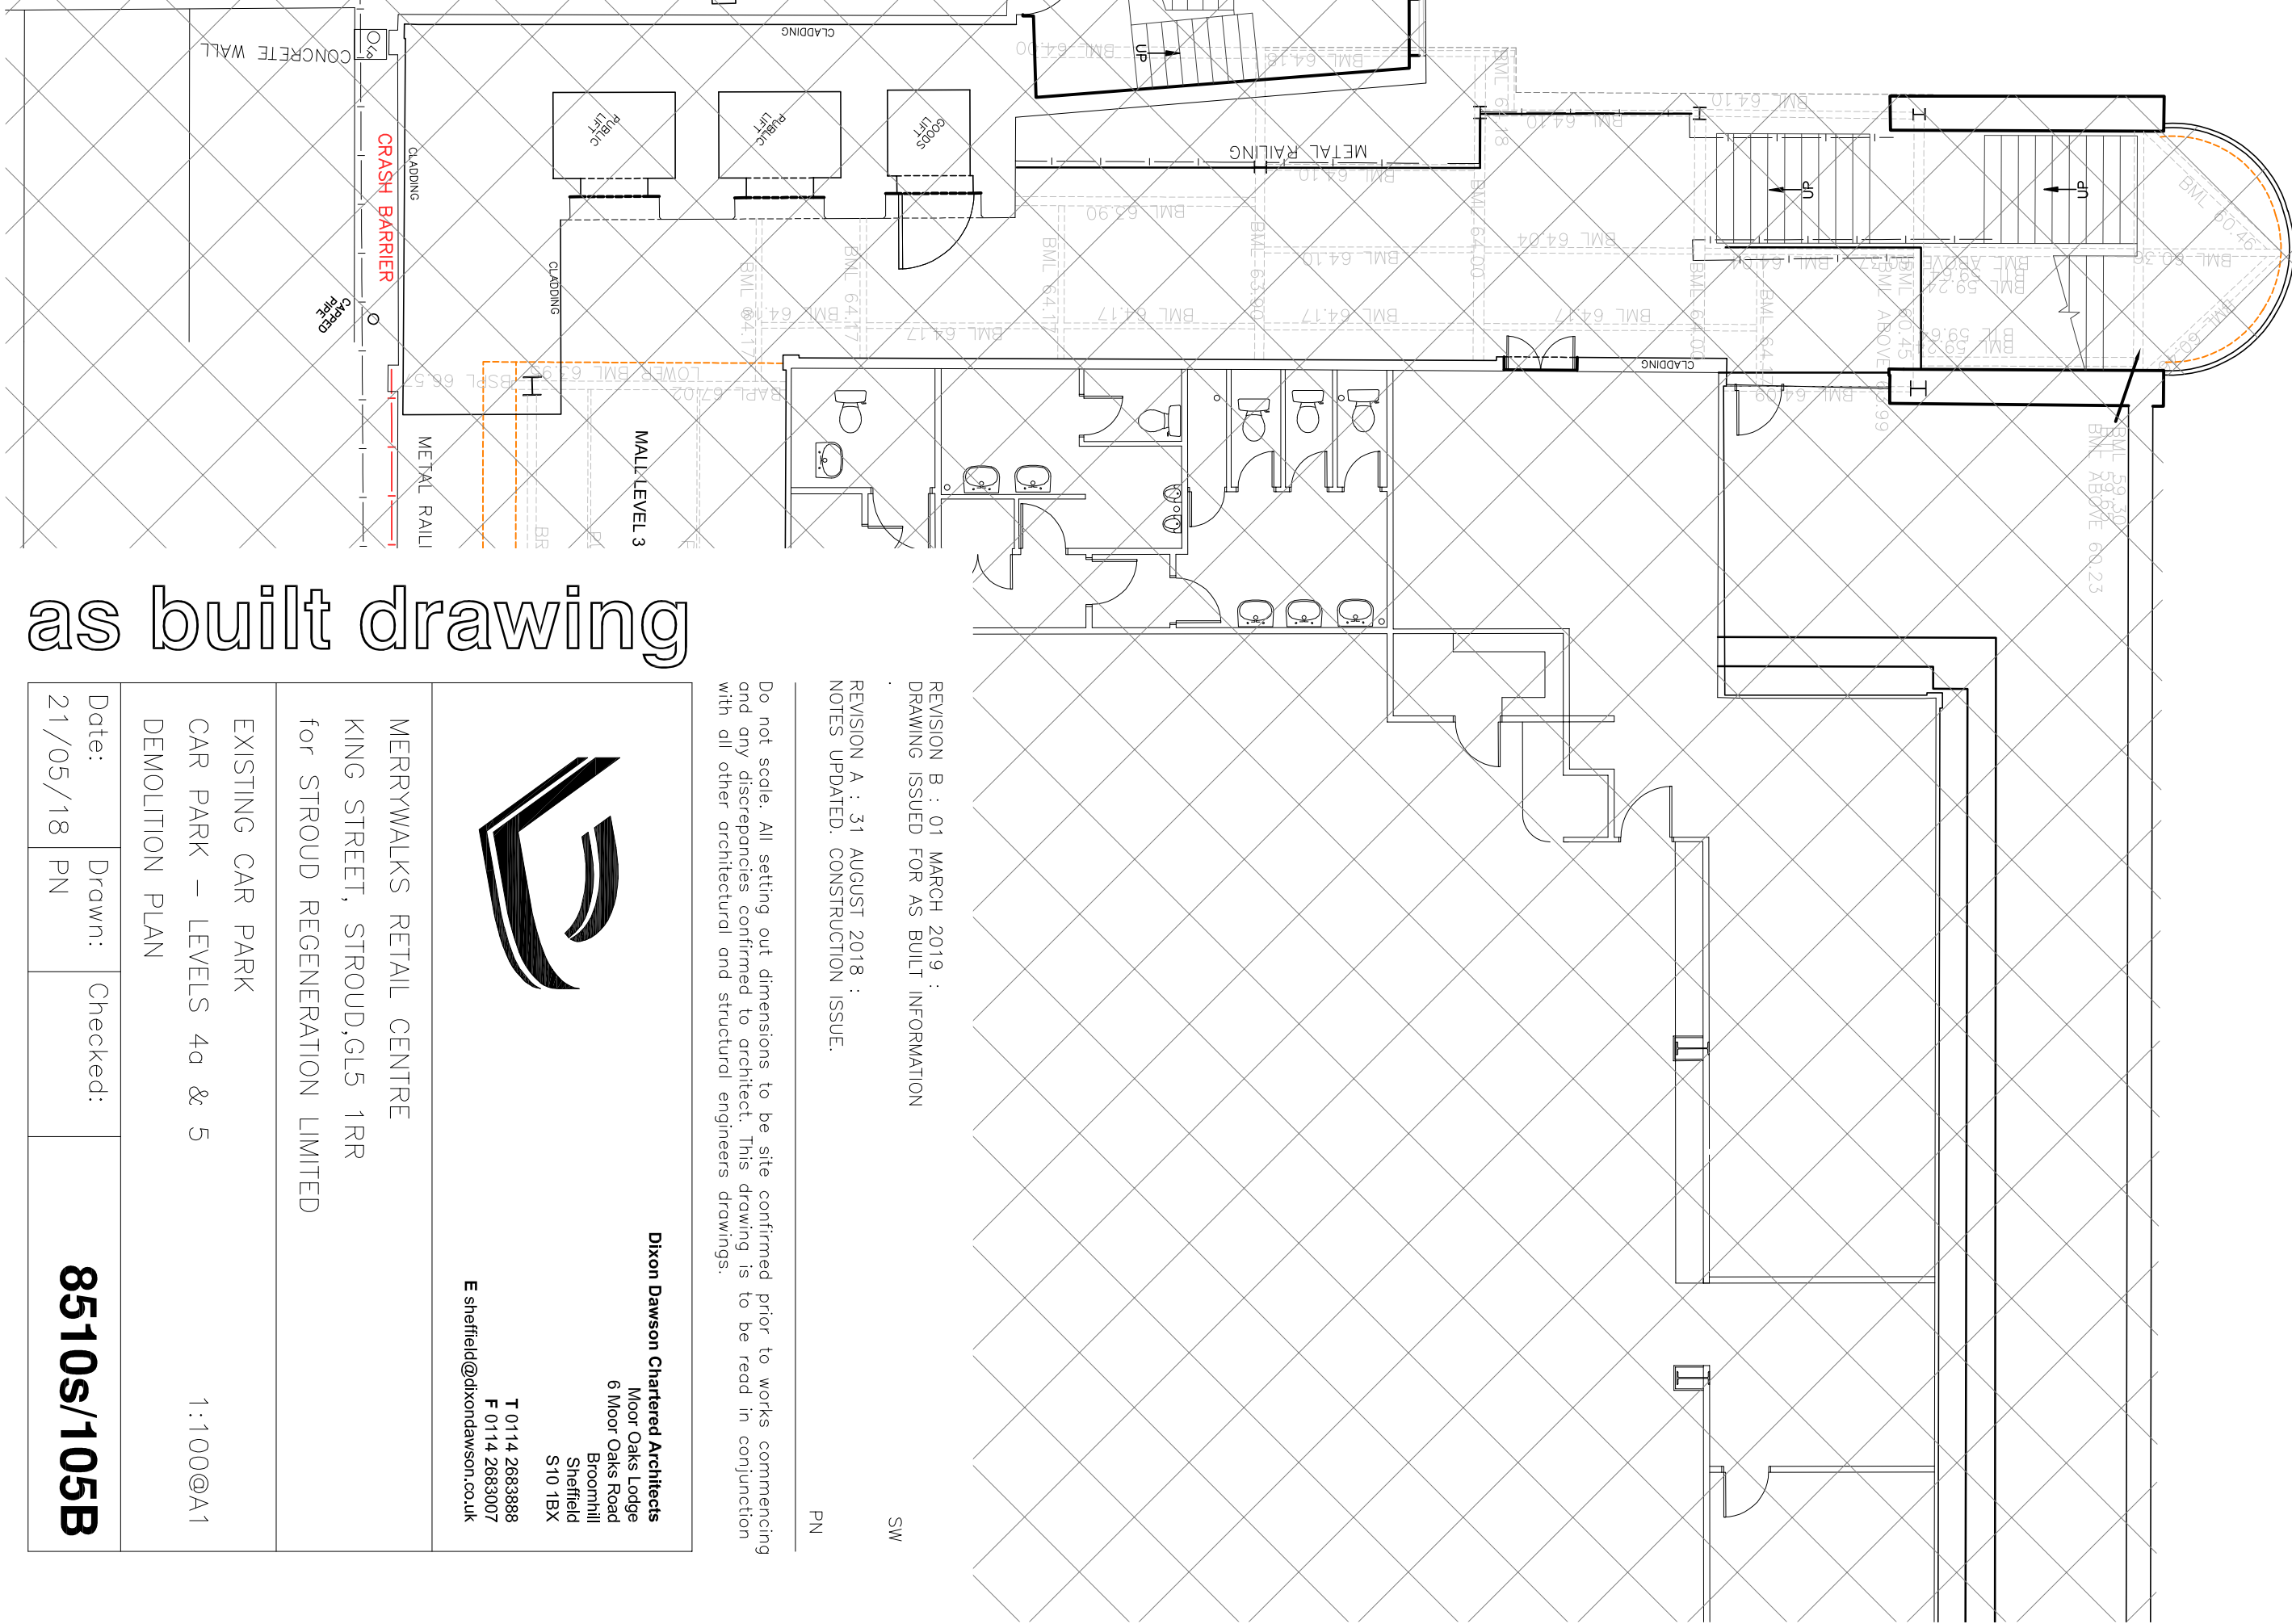

as built drawing

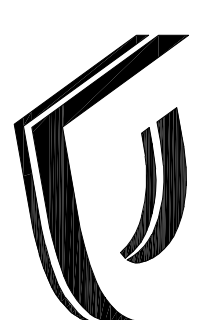		Dixon Dawson Chartered Architects 6 Moor Oaks Road Bromhill S10 1BX T 0114 2683888 E swillsh@dixondawson.co.uk	
MERRYWALKS RETAIL CENTRE KING STREET, STROUD, G15 1RR for STROUD REGENERATION LIMITED		EXISTING CAR PARK CAR PARK – LEVELS 4a & 5 DEMOLITION PLAN	
Date:	Drawn:	Checked:	8510s/105B
21/05/18	PN		