


Proposed Car park level 0 & 1 plan
Scale 1:100



as built drawing

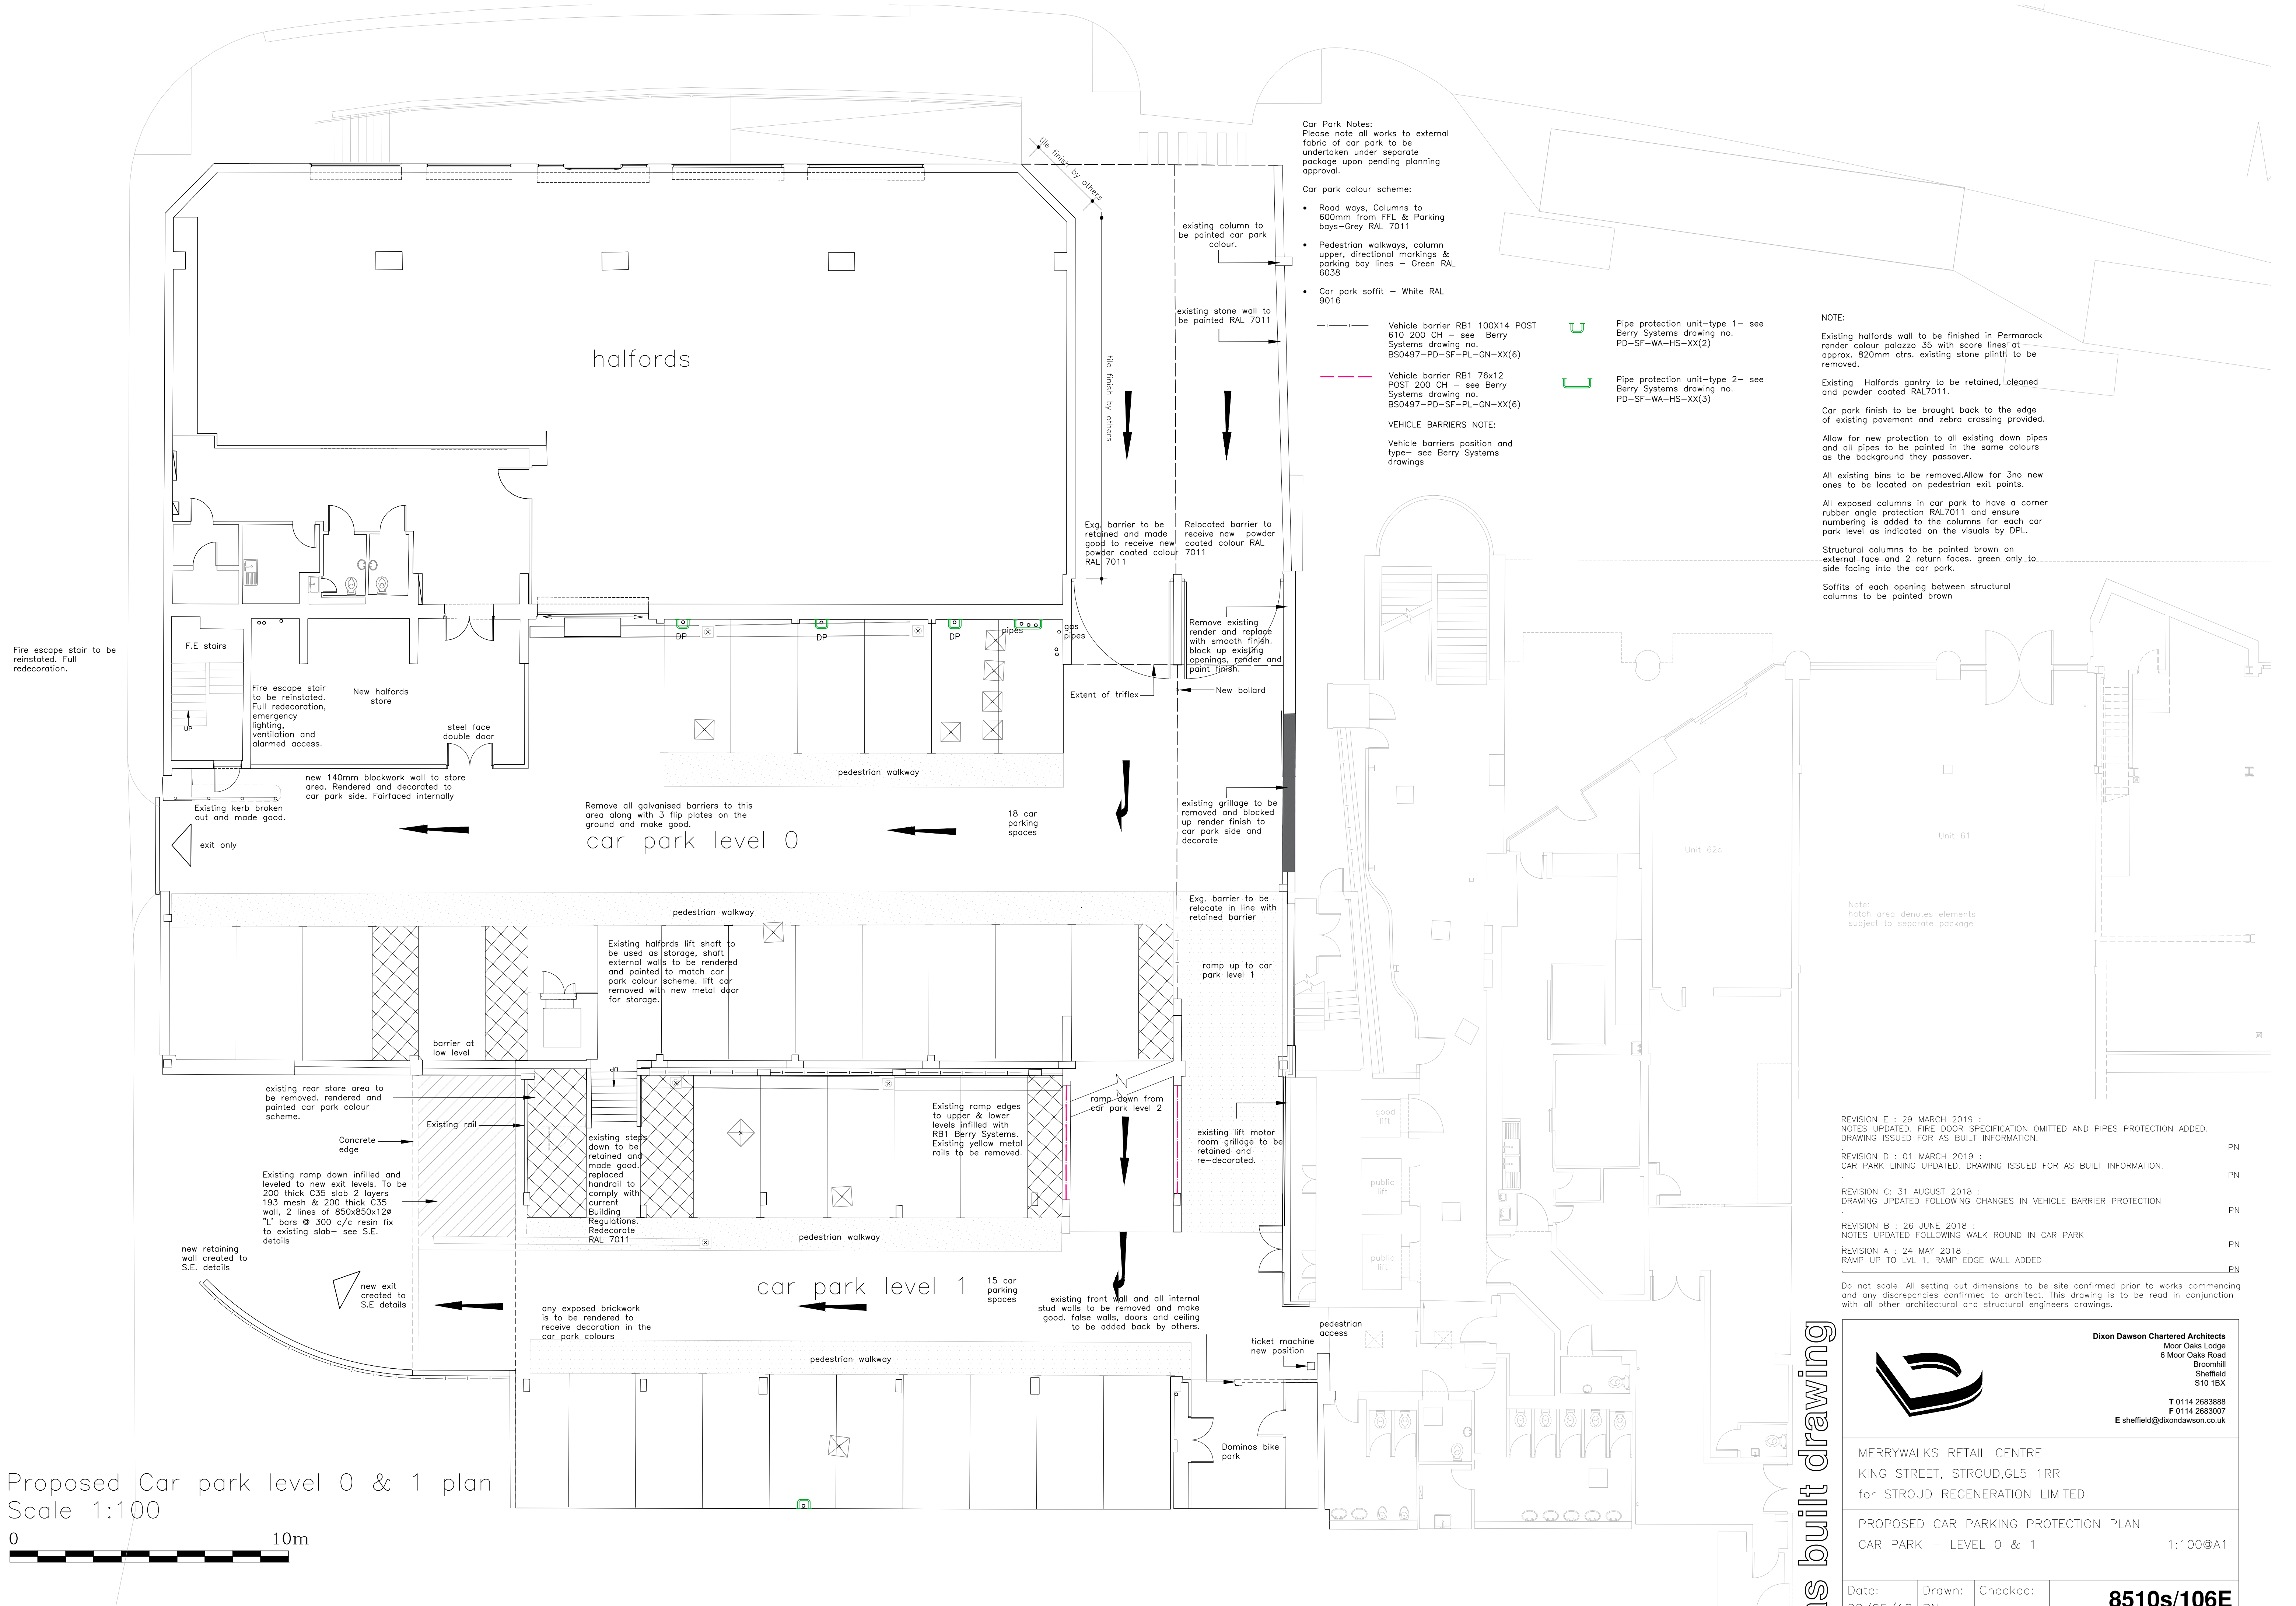

Dixon Dawson Chartered Architects
Moor Oaks Lodge
6 Moor Oaks Road
Broomhill
Sheffield
S10 1BX

T 0114 2683888
F 0114 2683007
E sheffield@dixondawson.co.uk

MERRYWALKS RETAIL CENTRE
KING STREET, STROUD, GL5 1RR
for STROUD REGENERATION LIMITED

PROPOSED CAR PARKING PROTECTION PLAN
CAR PARK – LEVEL 0 & 1
1:100@A1

Date: 22/05/18	Drawn: PN	Checked:	8510s/106E
-------------------	--------------	----------	-------------------