
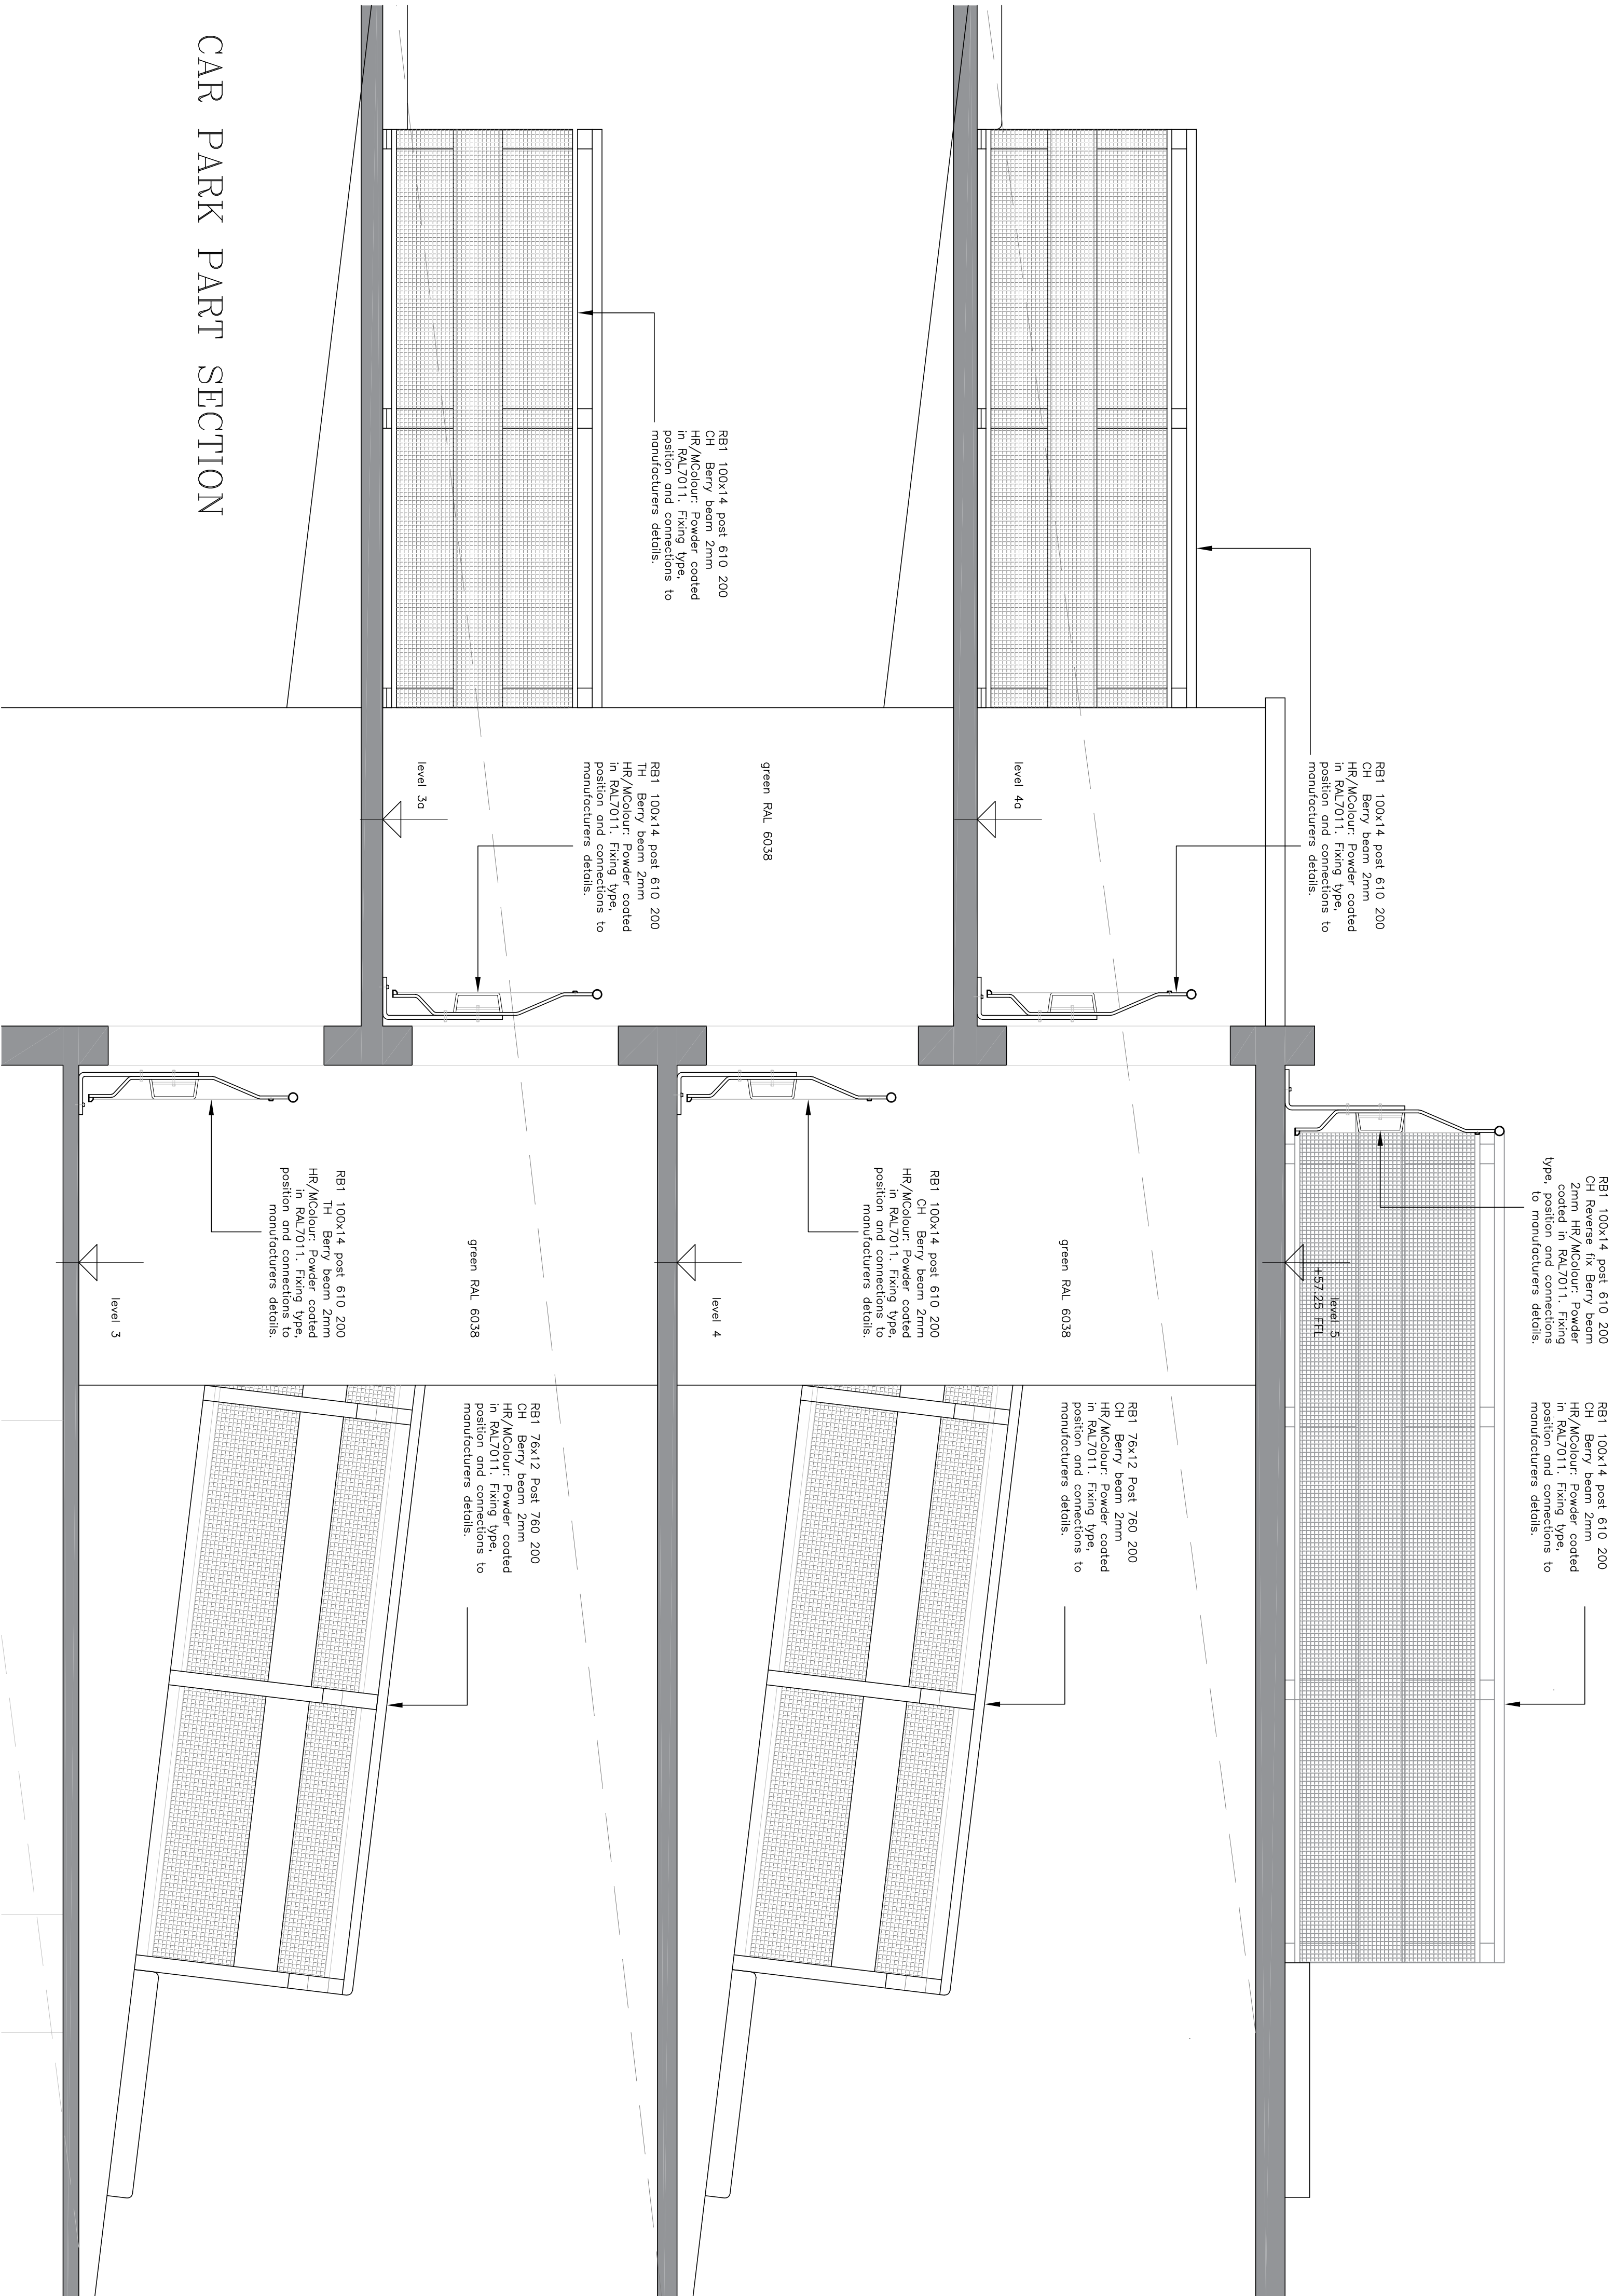


## CAR PARK PART SECTION

PROPOSED RAMP EDGE ELEVATION  
scale:1:20

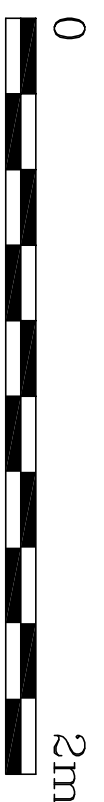

as built drawing

		
<p><b>Dixon Dawson Chartered Architects</b>          Moor Oak Lodge          6 Moor Oak Lane          Broomfield          Sheffield          S10 1BX</p> <p><b>T 0114 2683888          F 0114 2683507          E <a href="mailto:sheffield@dixondawson.co.uk">sheffield@dixondawson.co.uk</a></b></p>		
<p>MERRYWALKS RETAIL CENTRE          KING STREET, STROUD, GLS 1RR          for STROUD REGENERATION LIMITED</p>		
<p>PROPOSED CAR PARK PROTECTION DETAIL 2 OF 2          PROPOSED PLAN, ELEVATIONS &amp; SECTIONS          1:20@A1</p>		
Date:	Drawn:	Checked:
18/05/18	PN	
<p><b>8510S/121B</b></p>		