

- Road ways, Columns to 600mm from FFL & Parking bays—Grey RAL 7011
- Pedestrian walkways, column upper, directional markings & parking bay lines – Green RAL 6038
- Car park soffit – White RAL 9016


- Vehicle barrier RB1 100X14 POST  
610 200 CH - see Berry  
Systems drawing no.  
BS0497-PD-SF-EL-GN-XX(5)

- Vehicle barrier RB1 76x12  
POST 200 CH - see Berry  
Systems drawing no.  
BS0497-PD-SF-EL-GN-XX(5)

VEHICLE BARRIERS NOTE:  
Vehicle barriers position and  
type— see Berry Systems  
drawings.


Pipe protection unit-type 2- see  
Berry Systems drawing no.  
PD-SF-WA-HS-XX(3)

Soffits of each opening between structural columns to be painted brown

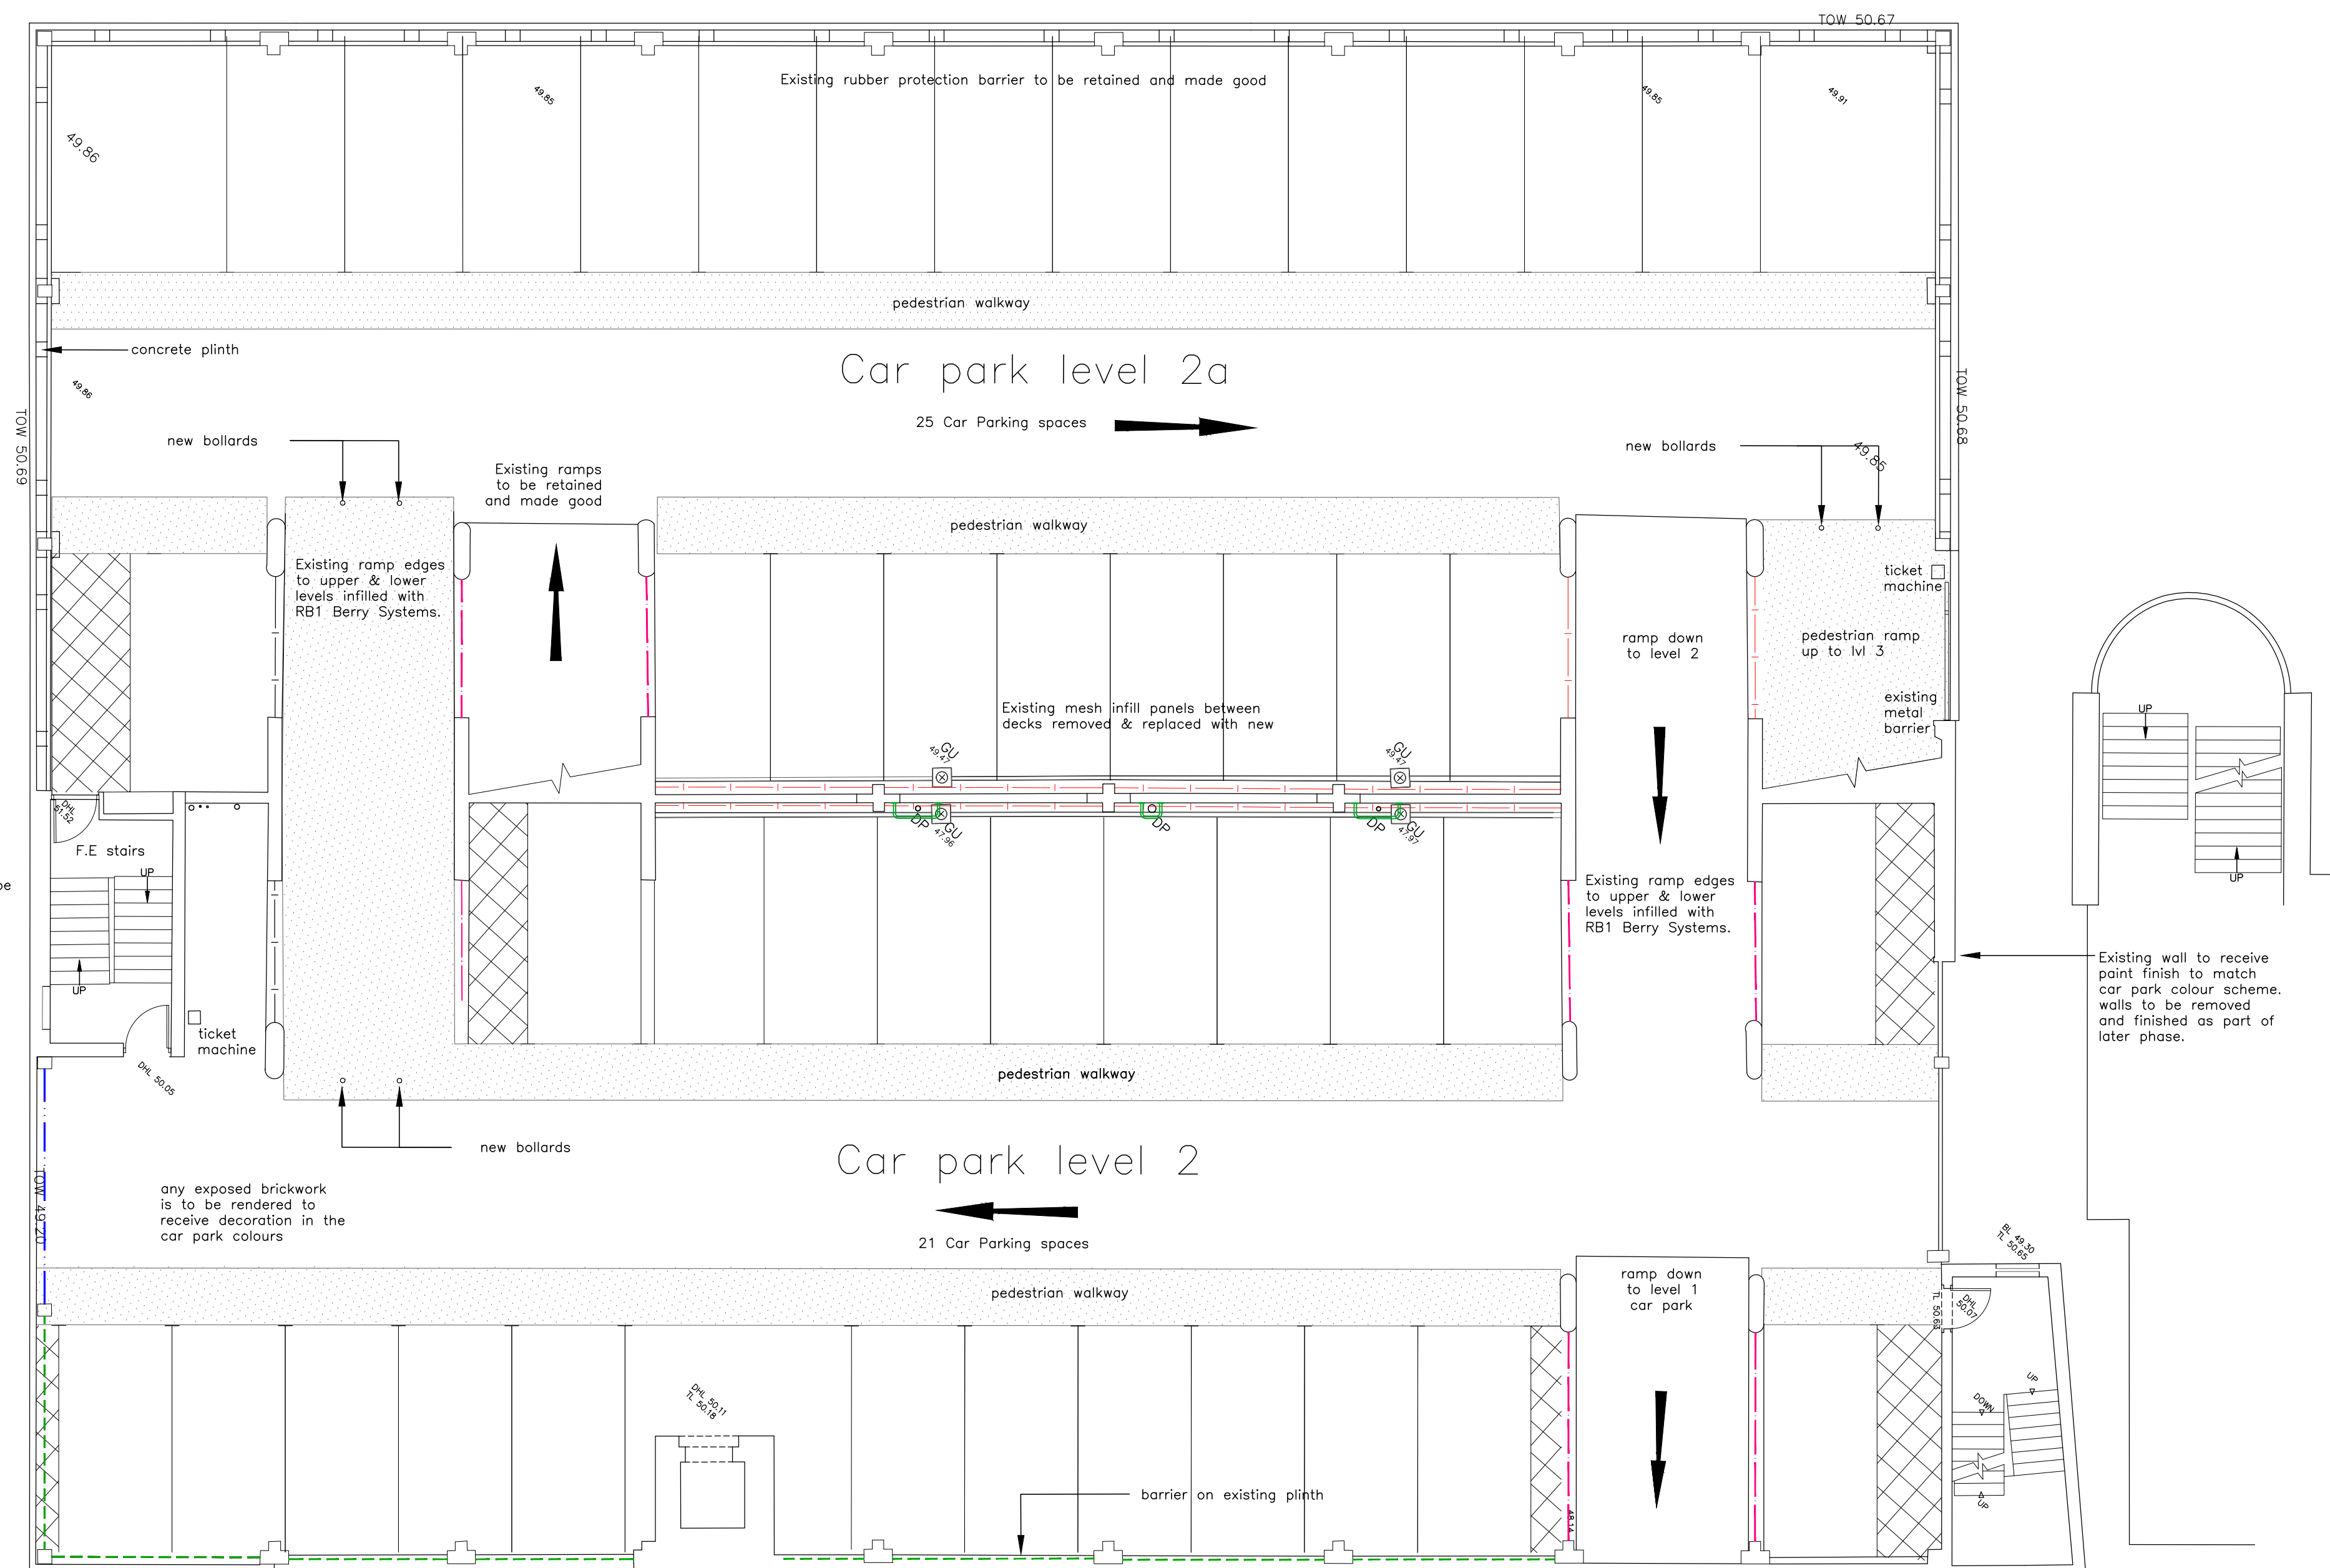

REVISION F : 29 MARCH 2019 : NOTES UPDATED. FIRE DOOR SPECIFICATION OMITTED AND PIES PROTECTION ADDED. DRAWING ISSUED FOR AS BUILT INFORMATION.	PN
REVISION E : 01 MARCH 2019 : BOLLARD LOCATIONS & CAR PARK LINING UPDATED, NOTES UPDATED. DRAWING ISSUED FOR AS BUILT INFORMATION.	PN
REVISION D : 31 AUGUST 2018 : DRAWING UPDATED FOLLOWING CHANGES TO THE VEHICLE BARRIER SYSTEM	SW
REVISION C : 26 JUNE 2018 : NOTES UPDATED FOLLOWING WALK ROUND IN THE CAR PARK.	PN
REVISION B : 04 JUNE 2018 : ROAD SIGN UPDATED	PN
REVISION A : 24 MAY 2018 : RB1 KEY SIGN UPDATED	PN

Do not scale. All setting out dimensions to be site confirmed prior to works commencing and any discrepancies confirmed to architect. This drawing is to be read in conjunction with all other architectural and structural engineers drawings.

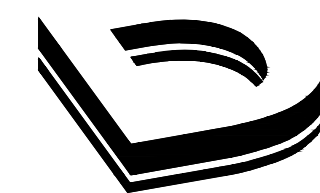

**Dixon Dawson Chartered Architects**  
Moor Oaks Lodge  
6 Moor Oaks Road  
Broomhill  
Sheffield  
S10 1BX

**T 0114 2683888**  
**F 0114 2683007**  
**E [sheffield@dixondawson.co.uk](mailto:sheffield@dixondawson.co.uk)**

MERRYWALKS RETAIL CENTRE KING STREET, STROUD, GL5 1RR for STROUD REGENERATION LIMITED	
PROPOSED CAR PARKING PROTECTION PLAN CAR PARK – LEVEL 2 & 2a	1:100@A1

Date: 22/05/18	Drawn: PN	Checked:	<b>8510s/107F</b>
-------------------	--------------	----------	-------------------

# as built drawing

Proposed Car park level 2 & 2a plan  
Scale 1:100