

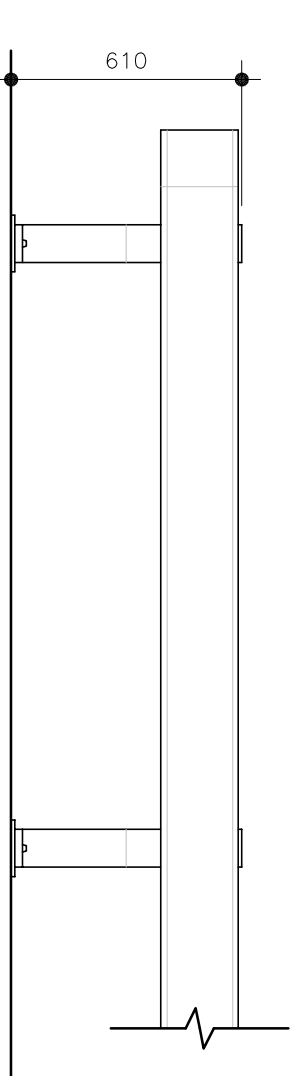




PROPOSED BOLLARDS ELEVATION  
scale:1:20

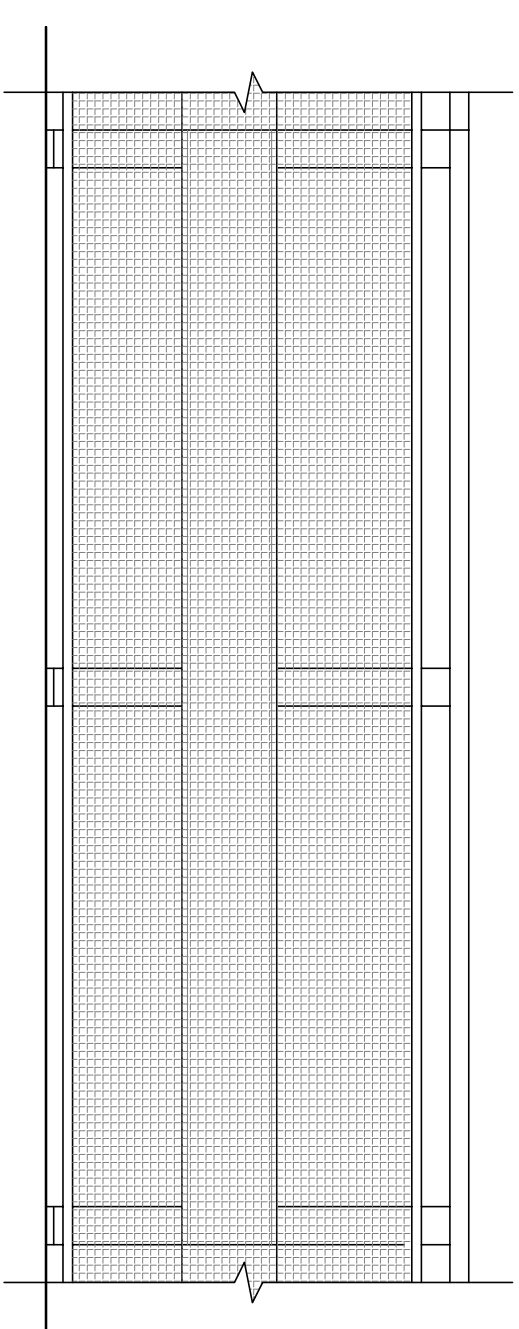




CAR BARRIER ELEVATION (RB1X)  
scale:1:20

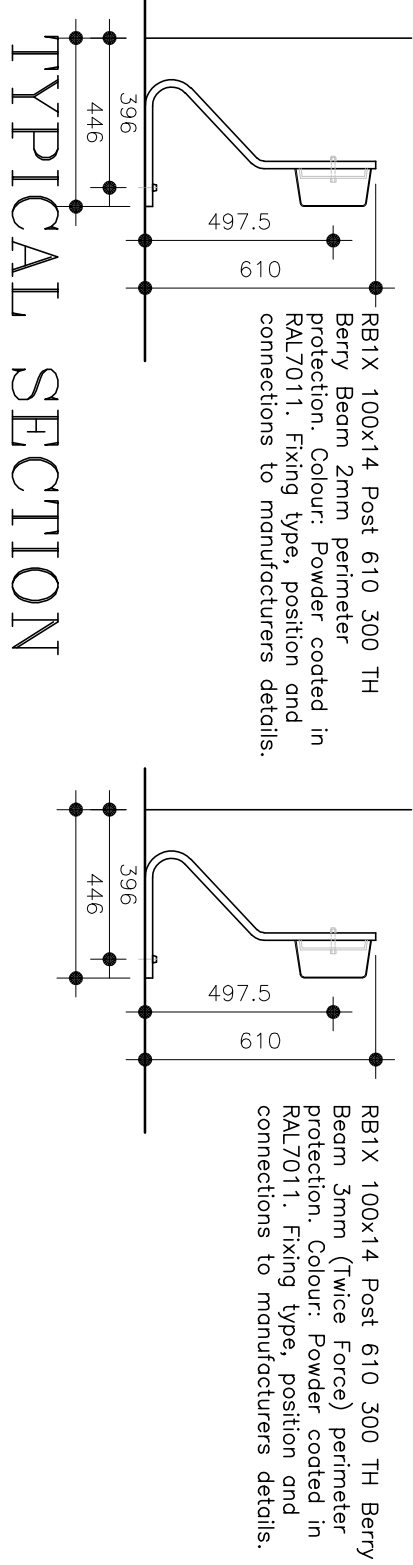


TYPICAL ELEVATION (RB1)  
scale:1:20

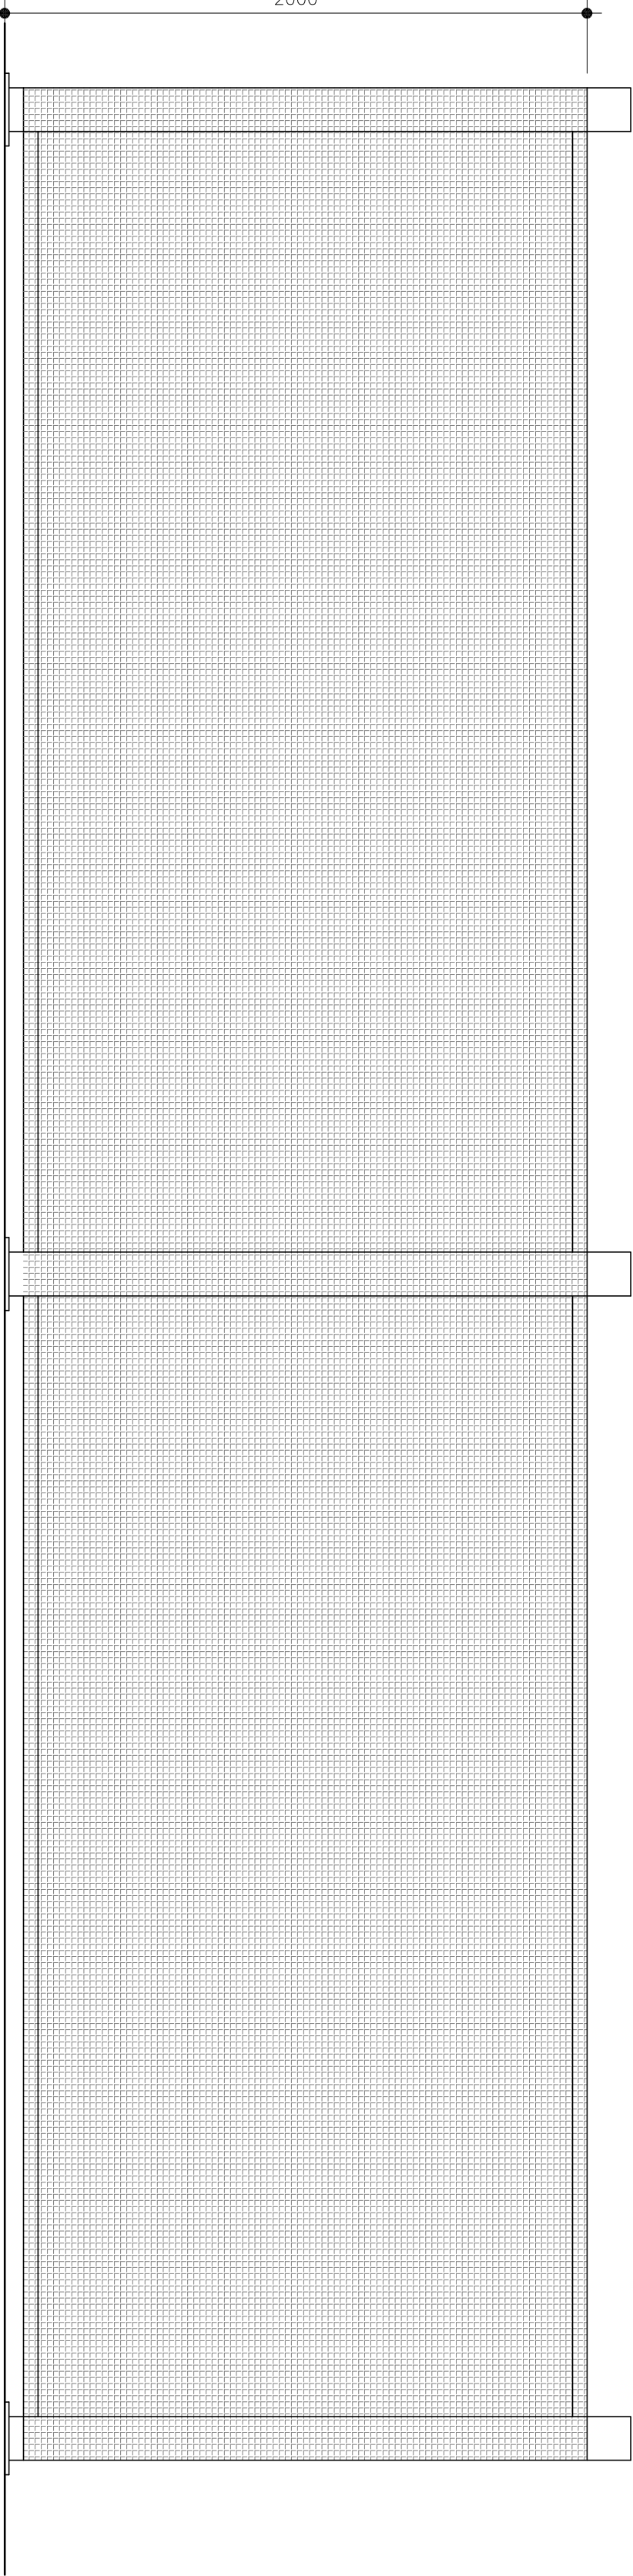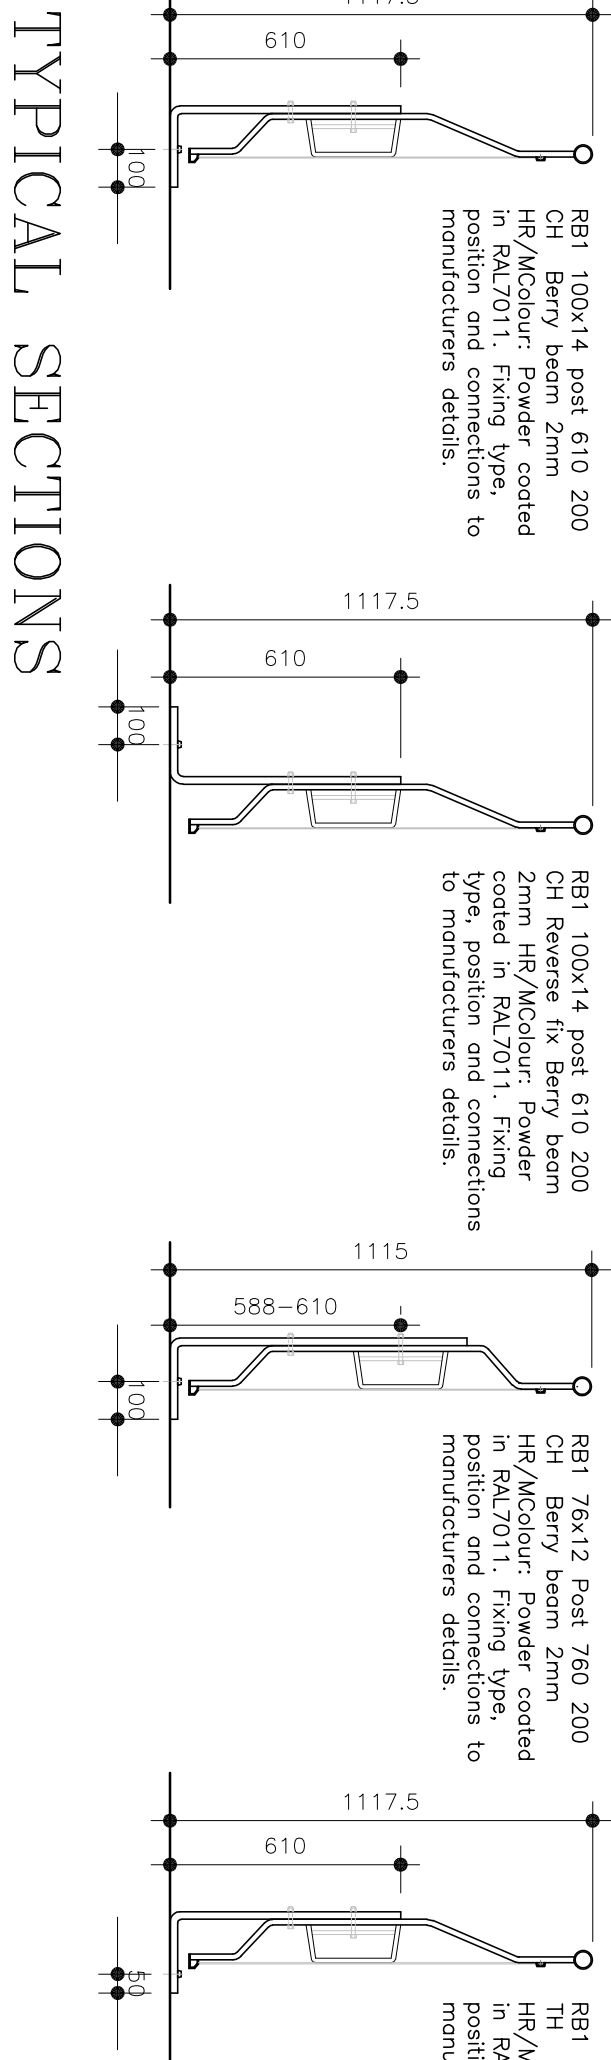

PERIMETER BARRIER PROPOSED ELEVATION  
scale:1:20

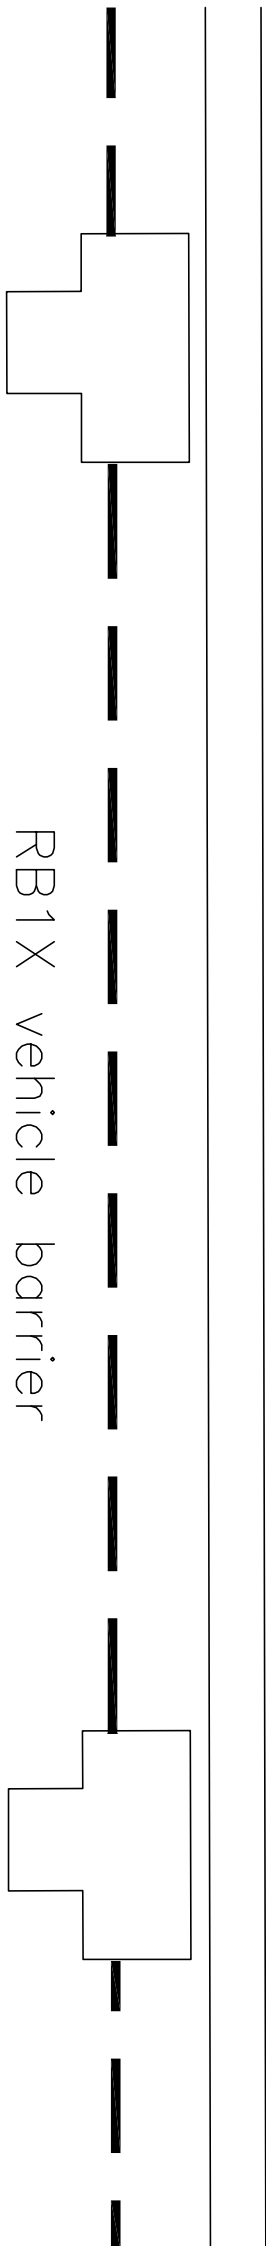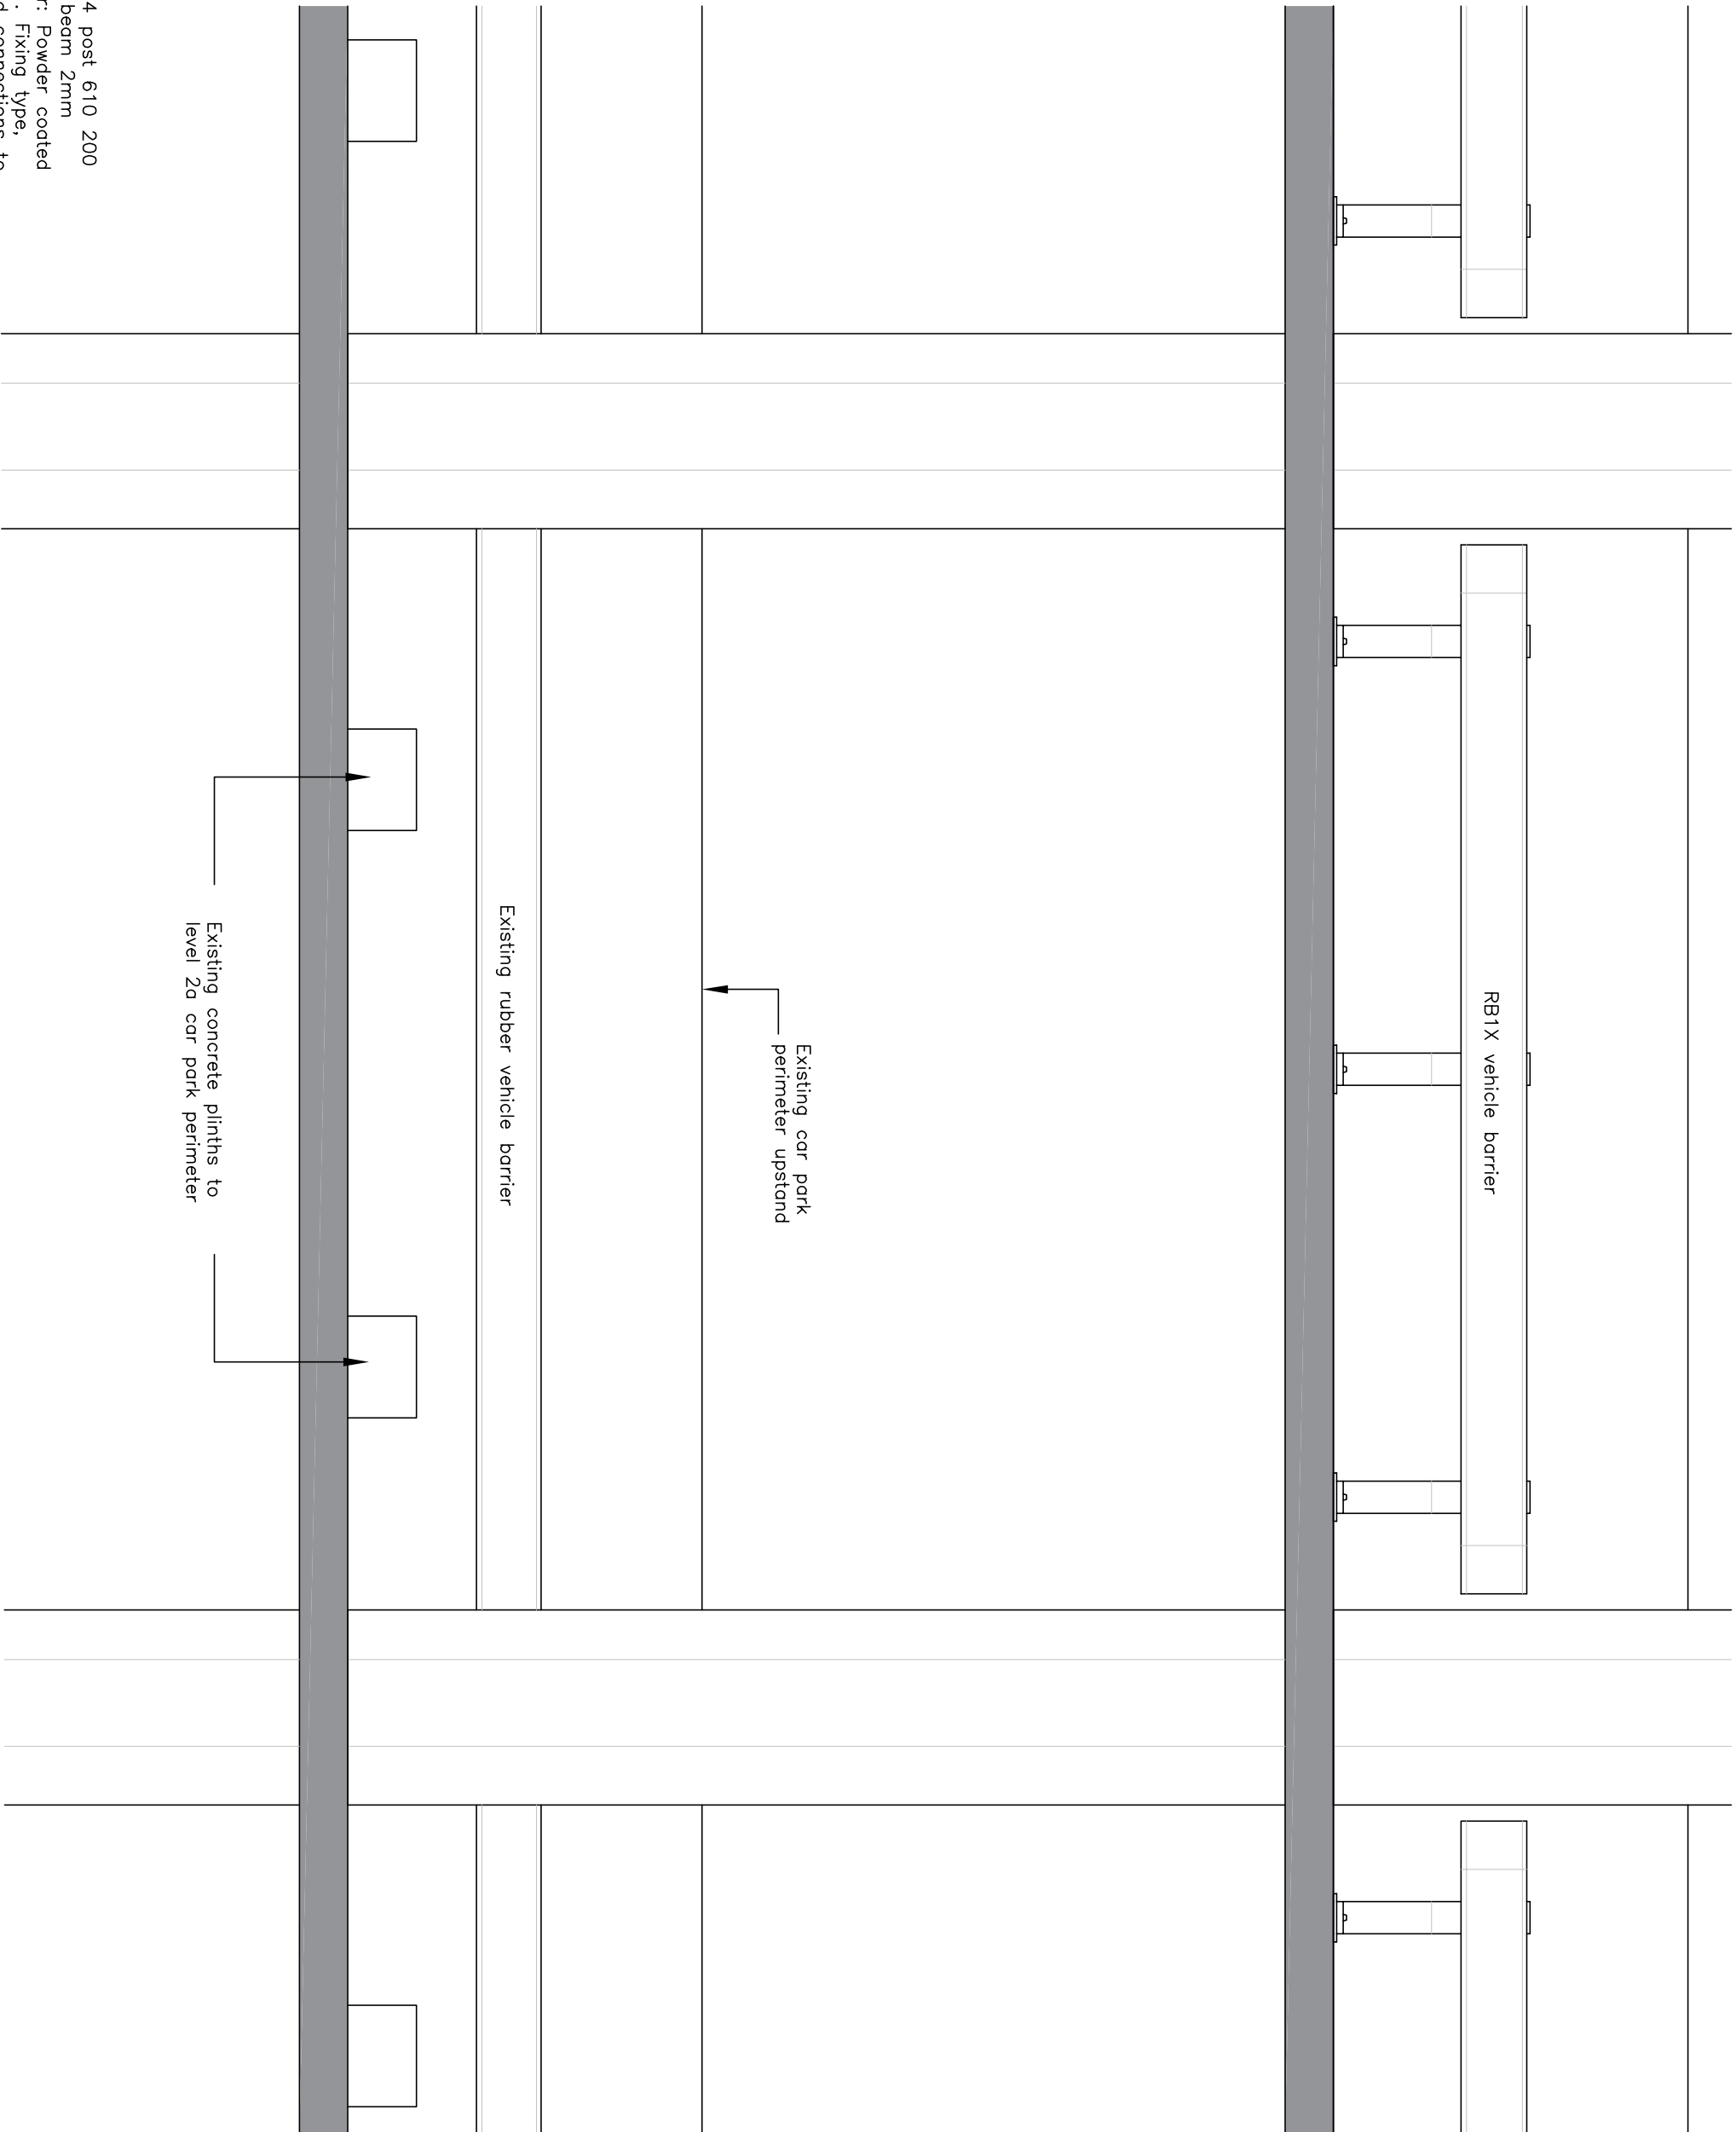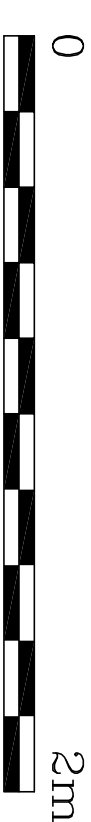

TYPICAL ELEVATION & PLAN CAR BARRIER RB1X  
scale:1:20

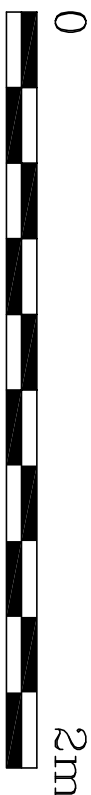

as built drawing

			
Dixon Dawson Chartered Architects Moor Oaks Lodge 6 Moor Oaks Broomhill Sheffield S10 1BX E: sheffield@dixondawson.co.uk T 0114 2683889 F 0114 2683007			
MERRYWALKS RETAIL CENTRE KING STREET, STROUD, GL5 1RR for STROUD REGENERATION LIMITED			
PROPOSED CAR PARK PROTECTION DETAIL 1 OF 2			
PROPOSED PLAN, ELEVATIONS & SECTIONS		1:20@A1	
Date: 18/05/18	Drawn: PN	Checked:	8510s/120C

Do not scale. All setting out dimensions to be site confirmed prior to works commencing and any discrepancies confirmed to architect. This drawing is to be read in conjunction with all other architectural and structural engineers drawings.

REVISION C : 01 MARCH 2019 :  
DRAWING ISSUED FOR AS BUILT INFORMATION

REVISION B : 31 OCTOBER 2018 :  
VEHICLE BARRIERS UPDATED

REVISION A : 06 JUNE 2018 :  
RAIL COLOUR ADDED TO VEHICLE BARRIERS

SW

PN

PN