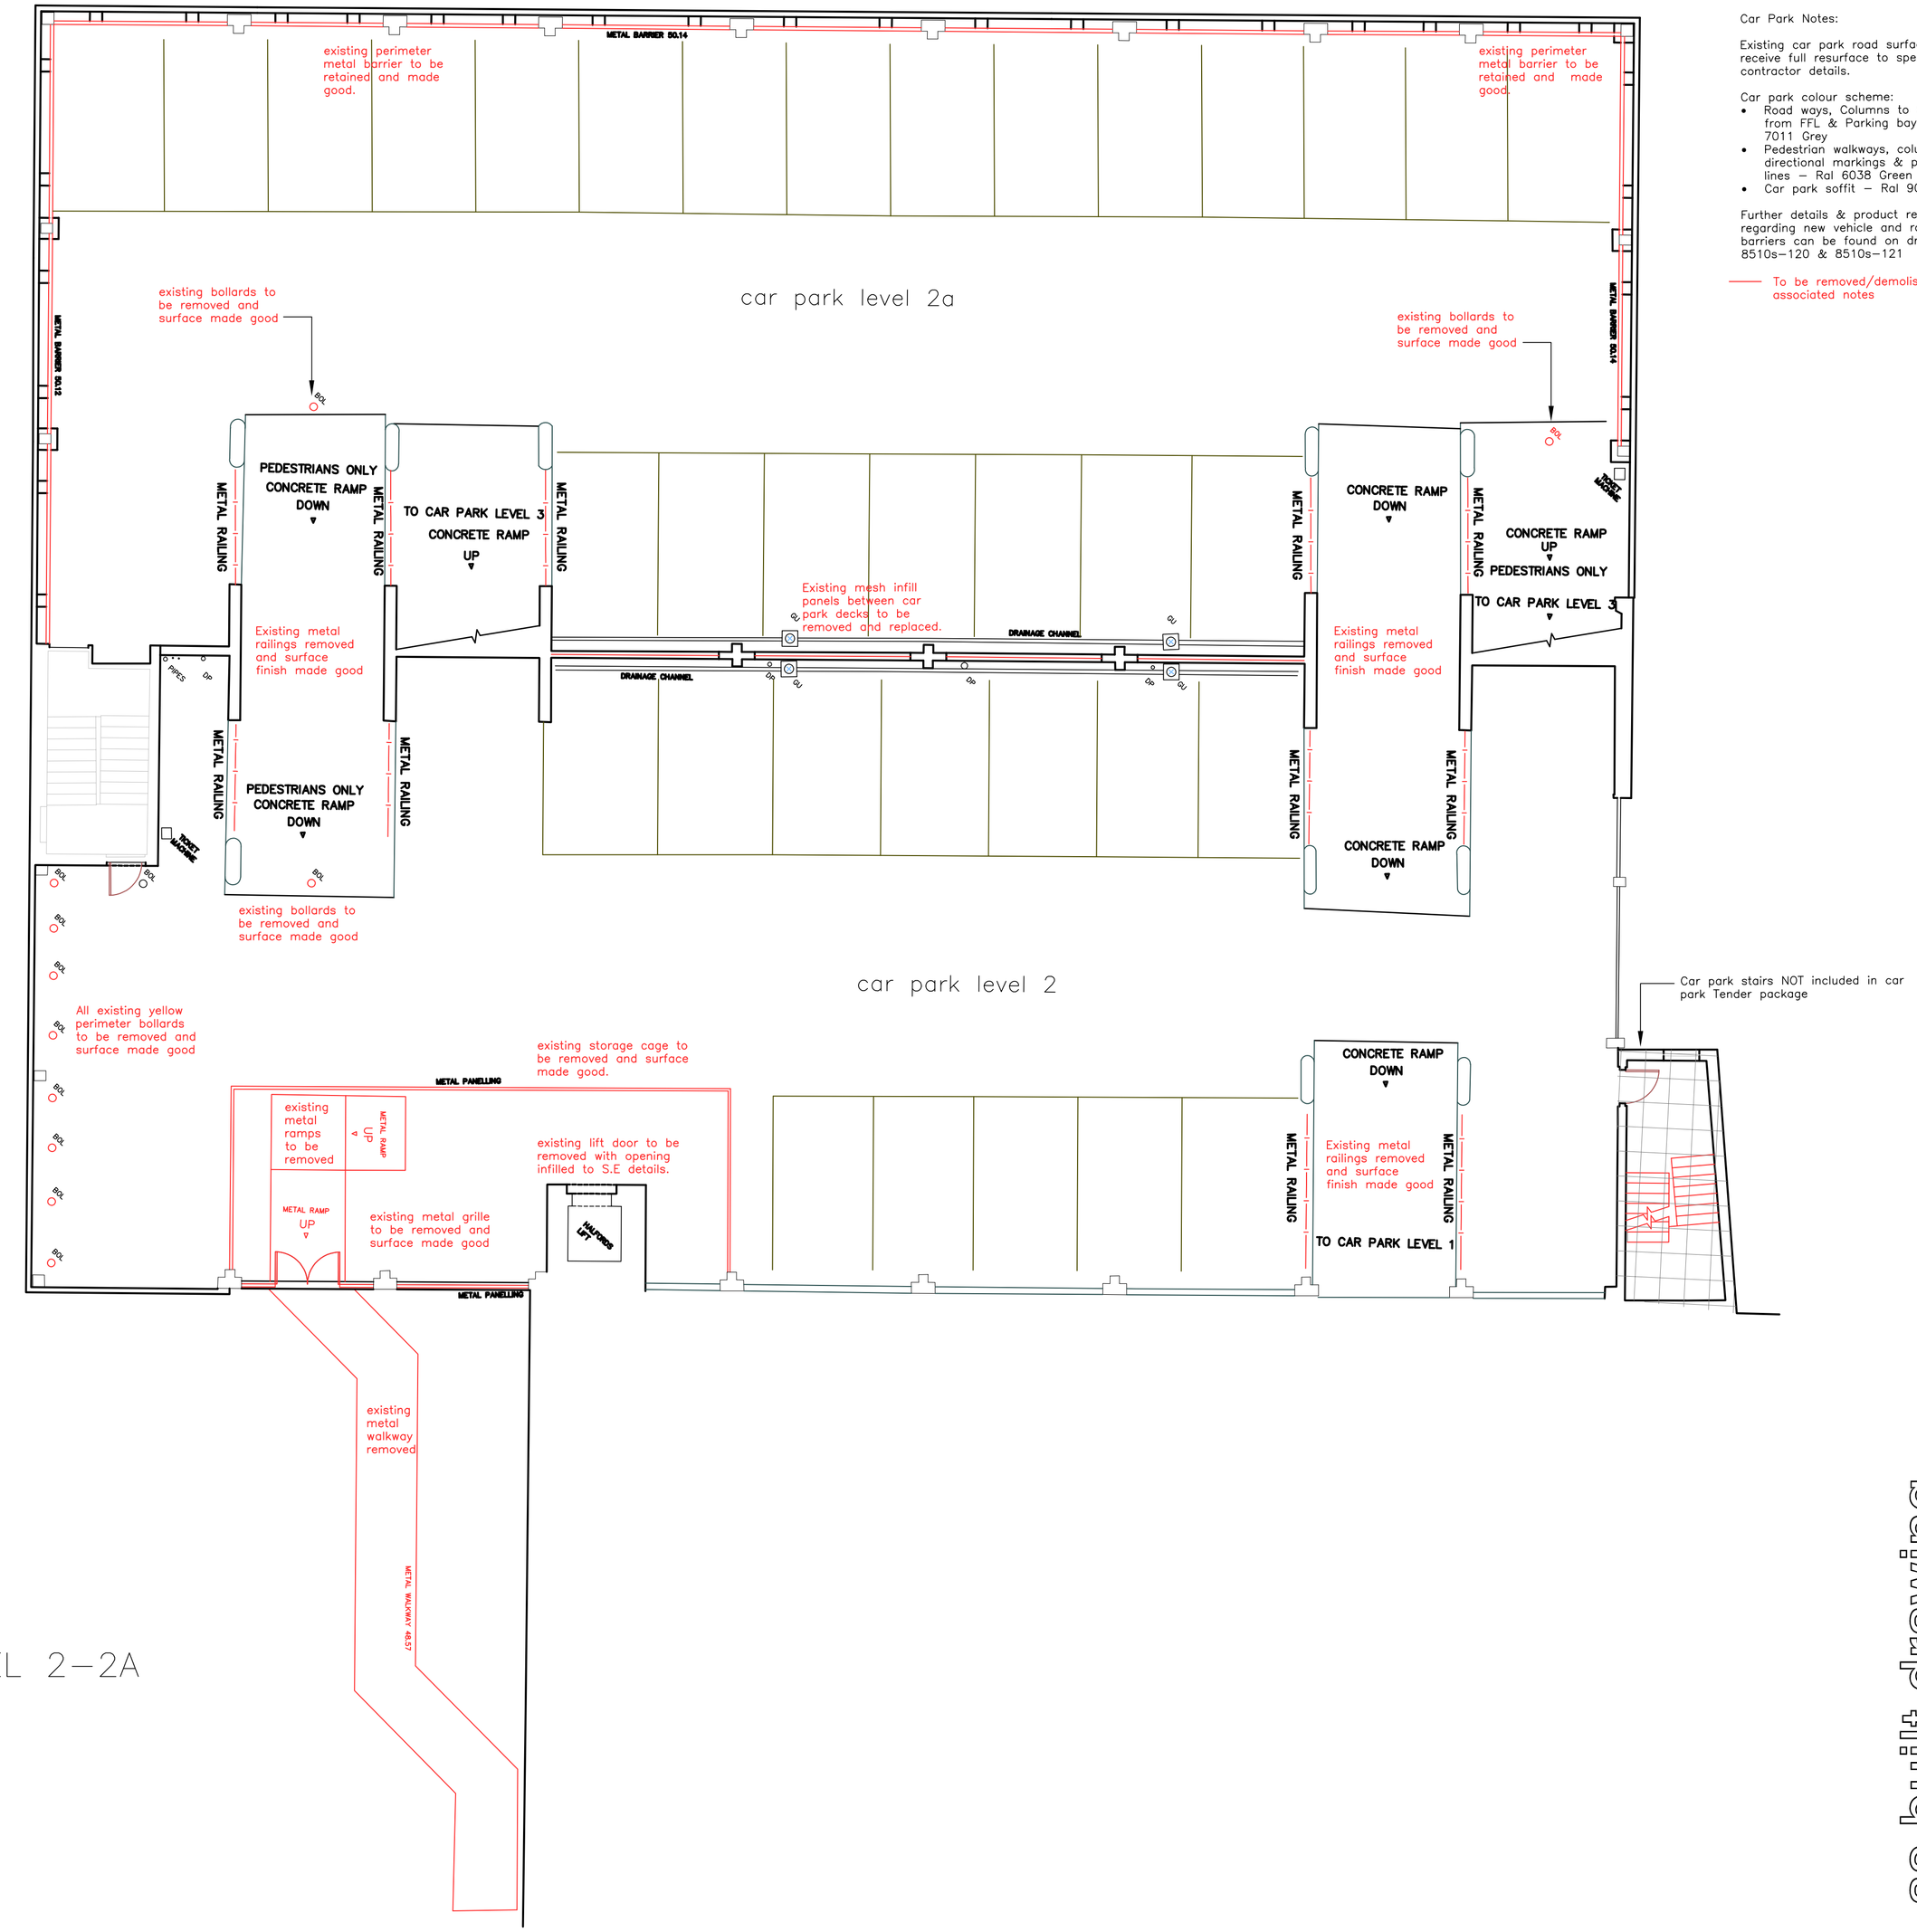

Car Park Notes:

Existing car park road surface to receive full resurface to specialist contractor details.

Car park colour scheme:

- Road ways, Columns to 600mm from FFL & Parking bays – Ral 7011 Grey
- Pedestrian walkways, column upper, directional markings & parking bay lines – Ral 6038 Green
- Car park soffit – Ral 9016 White

Further details & product references regarding new vehicle and ramp barriers can be found on drawings 8510s–120 & 8510s–121

—— To be removed/demolished. See associated notes

EXISTING CAR PARK PLAN LEVEL 2–2A
Demolition plan
Scale 1:100

0 10m

REVISION B : 01 MARCH 2019 : DRAWING ISSUED FOR AS BUILT INFORMATION SW

REVISION A : 31 AUGUST 2018 : NOTES UPDATED, CONSTRUCTION ISSUE PN

Do not scale. All setting out dimensions to be site confirmed prior to works commencing and any discrepancies confirmed to architect. This drawing is to be read in conjunction with all other architectural and structural engineers drawings.

as built drawing

Dixon Dawson Chartered Architects
Moor Oaks Lodge
6 Moor Oaks Road
Broomhill
Sheffield
S10 1BX

T 0114 2683888
F 0114 2683007
E sheffield@dixondawson.co.uk

MERRYWALKS RETAIL CENTRE
KING STREET, STROUD,GL5 1RR
for STROUD REGENERATION LIMITED

EXISTING CAR PARK
CAR PARK – LEVEL 2 & 2A 1:100@A1
DEMOLITION PLAN

Date:	Drawn:	Checked:	
21/05/18	PN		**8510s/102B**